


1 LOCATION OF WATER WELL: Fraction SE 1/4 SE 1/4 SE 1/4 Section Number 33 Township Number T 5 S Range Number R 3 E/W  
 County: Cloud

Distance and direction from nearest town or city street address of well if located within city?  
525 E. 11th, Concordia, Kansas

2 WATER WELL OWNER: Max Pettit  
 RR#, St. Address, Box #: 525 E. 11th Board of Agriculture, Division of Water Resources  
 City, State, ZIP Code: Concordia, KS Application Number:

3 LOCATE WELL'S LOCATION WITH AN "X" IN SECTION BOX: 4 DEPTH OF COMPLETED WELL: 148 ft. ELEVATION:  
 Depth(s) Groundwater Encountered 1. . . . . ft. 2. . . . . ft. 3. . . . . ft.

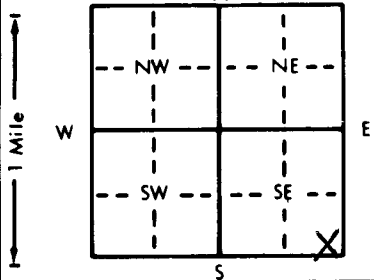

WELL'S STATIC WATER LEVEL . . . . . ft. below land surface measured on mo/day/yr  
 Pump test data: Well water was . . . . . ft. after . . . . . hours pumping . . . . . gpm  
 Est. Yield . . . . . gpm Well water was . . . . . ft. after . . . . . hours pumping . . . . . gpm  
 Bore Hole Diameter: 10 in. to 150 ft., and . . . . . in. to . . . . . ft.  
 WELL WATER TO BE USED AS:  
 1 Domestic 3 Feedlot 7 Lawn and garden 10 Monitoring well  
 2 Irrigation 4 Industrial 5 Public water supply 8 Air conditioning 11 Injection well  
 6 Oil field water supply 9 Dewatering 12 Other (Specify below)  
 Was a chemical/bacteriological sample submitted to Department? Yes . . . . . No ; If yes, mo/day/yr sample was submitted  
 Water Well Disinfected? Yes  No

5 TYPE OF CASING USED:  
 1 Steel 3 RMP (SR) 5 Wrought iron 8 Concrete tile CASING JOINTS: Glued  Clamped . . . . .  
 2 PVC 4 ABS 6 Asbestos-Cement 9 Other (specify below) Welded . . . . .  
 7 Fiberglass Threaded . . . . .

Blank casing diameter 5 in. to 108 ft., Dia . . . . . in. to . . . . . ft., Dia . . . . . in. to . . . . . ft.  
 Casing height above land surface . . . . . 24 in., weight . . . . . lbs./ft. Wall thickness or gauge No. . . . .

TYPE OF SCREEN OR PERFORATION MATERIAL:  
 1 Steel 3 Stainless steel 5 Fiberglass 7 PVC 10 Asbestos-cement  
 2 Brass 4 Galvanized steel 6 Concrete tile 8 RMP (SR) 11 Other (specify) . . . . .  
 9 ABS 12 None used (open hole)

SCREEN OR PERFORATION OPENINGS ARE:  
 1 Continuous slot 3 Mill slot 5 Gauzed wrapped 8 Saw cut 11 None (open hole)  
 2 Louvered shutter 4 Key punched 6 Wire wrapped 9 Drilled holes  
 7 Torch cut 10 Other (specify) . . . . .

SCREEN-PERFORATED INTERVALS: From 108 ft. to 148 ft., From . . . . . ft. to . . . . . ft.  
 From . . . . . ft. to . . . . . ft., From . . . . . ft. to . . . . . ft.  
 GRAVEL PACK INTERVALS: From 85 ft. to 150 ft., From 52 ft. to 80 ft., From . . . . . ft. to . . . . . ft.  
 From . . . . . ft. to . . . . . ft., From . . . . . ft. to . . . . . ft.

6 GROUT MATERIAL: 1 Neat cement 2 Cement grout 3 Bentonite 4 Other . . . . .  
 Grout Intervals: From 0 ft. to 52 ft., From 80 ft. to 85 ft., From . . . . . ft. to . . . . . ft.

What is the nearest source of possible contamination:  
 1 Septic tank 4 Lateral lines 7 Pit privy 10 Livestock pens 14 Abandoned water well  
 2 Sewer lines 5 Cess pool 8 Sewage lagoon 11 Fuel storage 15 Oil well/Gas well  
 3 Watertight sewer lines 6 Seepage pit 9 Feedyard 12 Fertilizer storage 16 Other (specify below)  
Unknown

Direction from well? How many feet?

FROM	TO	LITHOLOGIC LOG	FROM	TO	PLUGGING INTERVALS
0	1	Topsoil			
1	19	Clay, Brown			
19	<del>32</del> 32	Sandstone, Red, Brown			
32	90	Shale			
90	121	Sandstone, Tan			
121	150	Sandstone, Dark Brown			

7 CONTRACTOR'S OR LANDOWNER'S CERTIFICATION: This water well was (1) constructed, (2) reconstructed, or (3) plugged under my jurisdiction and was completed on (mo/day/year) 8/17/00 and this record is true to the best of my knowledge and belief. Kansas Water Well Contractor's License No. 527 This Water Well Record was completed on (mo/day/yr) 8/21/00 under the business name of Go-Lore Services, Inc by (signature) Don Pettit