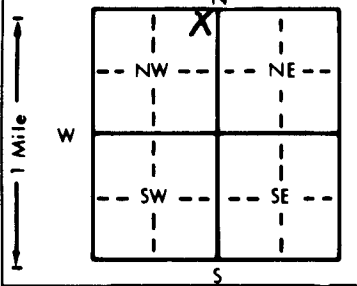


MW3

1 LOCATION OF WATER WELL: County: <u>Cloud</u>	Fraction <u>NE 1/4 NE 1/4 NW 1/4</u>	Section Number <u>21</u>	Township Number <u>T 05 S</u>	Range Number <u>R 03 EW</u>
---	---	-----------------------------	----------------------------------	--------------------------------

Distance and direction from nearest town or city street address of well if located within city?
3 miles North of Concordia on Hwy 81

2 WATER WELL OWNER: Walters Oil Co.
RR#, St. Address, Box # : Rt. 1 Box 18
City, State, ZIP Code : Cuba, KS 66940
Board of Agriculture, Division of Water Resources
Application Number: _____

3 LOCATE WELL'S LOCATION WITH AN "X" IN SECTION BOX:


4 DEPTH OF COMPLETED WELL: 35 ft. ELEVATION: 1306.76
Depth(s) Groundwater Encountered 1. 27 ft. 2. _____ ft. 3. _____ ft.
WELL'S STATIC WATER LEVEL 27.68 ft. below land surface measured on mo/day/yr 7/2/01
Pump test data: Well water was _____ ft. after _____ hours pumping _____ gpm
Est. Yield _____ gpm: Well water was _____ ft. after _____ hours pumping _____ gpm
Bore Hole Diameter: 8.25 in. to 35 in. and _____ in. to _____ ft.
WELL WATER TO BE USED AS:
5 Public water supply 8 Air conditioning 11 Injection well
1 Domestic 3 Feedlot 6 Oil field water supply 9 Dewatering 12 Other (Specify below)
2 Irrigation 4 Industrial 7 Lawn and garden only 10 Monitoring well
Was a chemical/bacteriological sample submitted to Department? Yes _____ No X; If yes, mo/day/yr sample was submitted _____
Water Well Disinfected? Yes _____ No (No)

5 TYPE OF BLANK CASING USED:
1 Steel 3 RMP (SR) 5 Wrought iron 8 Concrete tile CASING JOINTS: Glued _____ Clamped _____
2 PVC 4 ABS 6 Asbestos-Cement 9 Other (specify below) Welded _____
7 Fiberglass Threaded _____
Blank casing diameter 2 in. to 20 ft. Dia _____ in. to _____ ft. Dia _____ in. to _____ ft.
Casing height above land surface 7.08 in., weight 0.8 lbs./ft. Wall thickness or gauge No. Sch 40
TYPE OF SCREEN OR PERFORATION MATERIAL:
1 Steel 3 Stainless steel 5 Fiberglass 8 RMP (SR) 10 Asbestos-cement
2 Brass 4 Galvanized steel 6 Concrete tile 9 ABS 11 Other (specify) _____
12 None used (open hole)
SCREEN OR PERFORATION OPENINGS ARE:
1 Continuous slot 3 Mill slot 5 Gauzed wrapped 8 Saw cut 11 None (open hole)
2 Louvered shutter 4 Key punched 6 Wire wrapped 9 Drilled holes
7 Torch cut 10 Other (specify) _____
SCREEN-PERFORATED INTERVALS: From 20 ft. to 35 ft., From _____ ft. to _____ ft.
GRAVEL PACK INTERVALS: From 18 ft. to 35 ft., From _____ ft. to _____ ft.

6 GROUT MATERIAL: 1 Neat cement 2 Cement grout 3 Bentonite 4 Other _____
Grout intervals: From _____ ft. to _____ ft., From 1 ft. to 18 ft., From _____ ft. to _____ ft.
What is the nearest source of possible contamination:
1 Septic tank 4 Lateral lines 7 Pit privy 10 Livestock pens 14 Abandoned water well
2 Sewer lines 5 Cess pool 8 Sewage lagoon 11 Fuel storage 15 Oil well/Gas well
3 Watertight sewer lines 6 Seepage pit 9 Feedyard 12 Fertilizer storage 16 Other (specify below)
Lust Site
13 Insecticide storage
Direction from well? _____ How many feet? _____

FROM	TO	LITHOLOGIC LOG	FROM	TO	PLUGGING INTERVALS
0	5	Asphalt and crushed rock			
5	16	Clay			
16	24	Sand			
24	25.5	Clay			
25.5	26	Sandy clay			
26	35	Sand			

7 CONTRACTOR'S OR LANDOWNER'S CERTIFICATION: This water well was (1) constructed (2) reconstructed, or (3) plugged under my jurisdiction and was completed on (mo/day/year) 6/28/01 and this record is true to the best of my knowledge and belief. Kansas Water Well Contractor's License No. 394 This Water Well Record was completed on (mo/day/yr) 8/2/01 under the business name of Coranco Great Plains by (signature) _____

OFFICE USE ONLY
T
R
EW
SEC.
1/4
1/4
1/4