


WATER WELL RECORD Form WW-5 KSA 82a-1212

1 LOCATION OF WATER WELL: County: Cloud Fraction: SE ¼ NE ¼ NW ¼ Section Number: 21 Township Number: T 5 S Range Number: R 3 EW

Distance and direction from nearest town or city street address of well if located within city?
3 mi. north of Concordia on Hwy 81

2 WATER WELL OWNER: 81 Texaco
RR#, St Address, Box # : P.O. Box 667
City, State, ZIP Code : Salina, Kansas 67402 ASW-7 Board of Agriculture, Division of Water Resources Application Number:

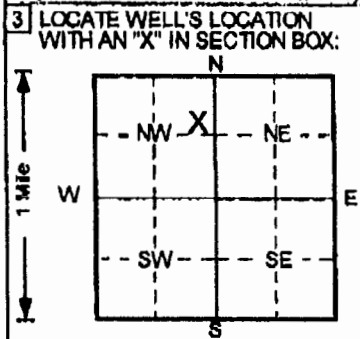

4 DEPTH OF COMPLETED WELL: 40 ft. ELEVATION: 1367.08

Depth(s) Groundwater Encountered: 1. ft. 2. ft. 3. ft.

WELL'S STATIC WATER LEVEL: ft. below land surface measured on mo/day/yr

Pump test data: Well water was NA ft. after NA hours pumping NA gpm

Est Yield NA gpm Well water was NA ft. after NA hours pumping NA gpm

Bore Hole Diameter: 2 in. to 40 ft. and in. to ft.

WELL WATER TO BE USED AS: 5 Public water supply 8 Air conditioning 11 Injection well
1 Domestic 3 Feedlot 8 Oil field water supply 9 Dewatering 12 Other (Specify below)
2 Irrigation 4 Industrial 7 Lawn and garden only 10 Monitoring well

Was a chemical/bacteriological sample submitted to Department? Yes No
Water Well Disinfected? Yes No

5 TYPE OF BLANK CASING USED:

1 Steel	3 RMP (SR)	5 Wrought iron	8 Concrete tile	CASING JOINTS: Glued Clamped
2 PVC	4 ABS	6 Asbestos-Cement	9 Other (specify below)	Welded
		7 Fiberglass		Threaded ✓

Blank casing diameter: 2 in. to 38 ft. Dia. 1.716 in. to ft. Dia. in. to ft.

Casing height above land surface: 0 in. weight 1.716 lbs./ft. Wall thickness or gauge No. 154

TYPE OF SCREEN OR PERFORATION MATERIAL:

1 Steel	3 Stainless steel	5 Fiberglass	7 PVC	10 Asbestos-cement
2 Brass	4 Galvanized steel	6 Concrete tile	8 RMP (SR)	11 Other (specify)
			9 ABS	12 None used (open hole)

SCREEN OR PERFORATION OPENINGS ARE:

1 Continuous slot	3 Mill slot	5 Gauzed wrapped	8 Saw cut	11 None (open hole)
2 Louvered shutter	4 Key punched	6 Wire wrapped	9 Drilled holes	
		7 Torch cut	10 Other (specify)	

SCREEN-PERFORATED INTERVALS: From 38 ft. to 40 ft.

GRAVEL PACK INTERVALS: From 36 ft. to 40 ft.

6 GROUT MATERIAL: 1 Neat cement 2 Cement grout 3 Bentonite 4 Other

Grout Intervals: From 0 ft. to 32 ft. From 32 ft. to 36 ft.

What is the nearest source of possible contamination:

1 Septo tank	4 Lateral lines	7 Pit privy	10 Livestock pens	14 Abandoned water well
2 Sewer lines	5 Cess pool	8 Sewage lagoon	11 Fuel storage	15 Oil well/Gas well
3 Watertight sewer lines	6 Seepage pit	9 Feedyard	12 Fertilizer storage	16 Other (specify below)
			13 Insecticide storage	

Direction from well? How many feet? 0

FROM	TO	LITHOLOGIC LOG	FROM	TO	PLUGGING INTERVALS

ASW7, Flushmount
Project Name: GF-81 Texaco
KDHE # AS 015 40055

7 CONTRACTOR'S OR LANDOWNER'S CERTIFICATION: This water well was (1) constructed, (2) reconstructed, or (3) plugged under my jurisdiction and was completed on (mo/day/year) 7/24/2003 and this record is true to the best of my knowledge and belief.

Kansas Water Well Contractor's License No. 554 This Water Well Record was completed on (mo/day/yr) 4/5/2004

under the business name of Wootler Pump & Well, Inc. by (signature) Gary C. Wootler

INSTRUCTIONS: Use typewriter or ball point pen. PLEASE PRESS FIRMLY and PRINT clearly. Please fill in blanks, underline or circle the correct answers. Send top three copies to Kansas Department of Health and Environment, Bureau of Water, Topeka, Kansas 66620-0001. Telephone: 913-296-8545. Send one to WATER WELL OWNER and retain one for your records.

OFFICE USE ONLY
T
R
EW
SEC.