

WATER WELL RECORD Form WWC-5 KSA 82a-1212


1) LOCATION OF WATER WELL:

County: Cloud	Fraction: SE ¼ NE ¼ NW ¼	Section Number: 21	Township Number: T 5 S	Range Number: R 3 E
---------------	--------------------------	--------------------	------------------------	---------------------

Distance and direction from nearest town or city street address of well if located within city?
 3 mi. north of Concordia on Hwy 81

2) WATER WELL OWNER: Walther's Oil Company
 RR#, St. Address, Box #: 2599 US Hwy 36
 City, State, ZIP Code: Cuba, KS 66940
 Application Number: VEW-5 Board of Agriculture, Division of Water Resources

3) LOCATE WELL'S LOCATION WITH AN "X" IN SECTION BOX:

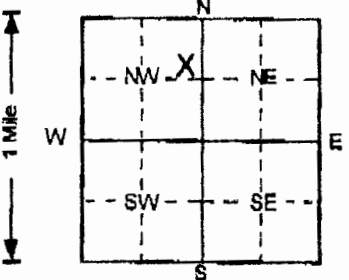

4) DEPTH OF COMPLETED WELL: 34.5 ft. ELEVATION: 1367.12
 Depth(s) Groundwater Encountered: 1. ft. 2. ft. 3. ft.
 WELL'S STATIC WATER LEVEL: ft. below land surface measured on mo/day/yr
 Pump test data: Well water was NA ft. after hours pumping gpm
 Est. Yield: NA gpm Well water was ft. after hours pumping gpm
 Bore Hole Diameter: 11 in. to 34.5 ft. and in. to ft.
 WELL WATER TO BE USED AS:
 1 Domestic 3 Feedlot 6 Oil field water supply 8 Air conditioning 11 Injection well
 2 Irrigation 4 Industrial 7 Lawn and garden only 10 Dewatering 12 Other (Specify below)
 2 Industrial 7 Vapor extraction
 Was a chemical/bacteriological sample submitted to Department? Yes No If yes, mo/day/yr sample was submitted
 Water Well Disinfectant? Yes No

5) TYPE OF BLANK CASING USED:
 1 Steel 3 RMP (SR) 5 Wrought Iron 8 Concrete tile
 2 PVC 4 ABS 6 Asbestos-Cement 9 Other (specify below)
 7 Fiberglass
 Casing joints: Glued Clamped Welded Threaded
 Blank casing diameter: 4 in. to 19.5 ft. Dia. in. to ft. Dia. in. to ft.
 Casing height above land surface: 0 in. weight: 210.71 lbs./ft. Wall thickness or gauge: .237

TYPE OF SCREEN OR PERFORATION MATERIAL:
 1 Steel 3 Stainless steel 5 Fiberglass 7 PVC 10 Asbestos-cement
 2 Brass 4 Galvanized steel 6 Concrete tile 8 RMP (SR) 11 Other (specify)
 12 None used (open hole)

SCREEN OR PERFORATION OPENINGS ARE:
 1 Continuous slot 3 Mill slot 5 Gauzed wrapped 8 Saw cut 11 None (open hole)
 2 Louvered shutter 4 Key punched 6 Wire wrapped 9 Drilled holes
 7 Torch cut 10 Other (specify)

SCREEN-PERFORATED INTERVALS: From 19.5 ft. to 34.5 ft. From ft. to ft.
 GRAVEL PACK INTERVALS: From 17.5 ft. to 34.5 ft. From ft. to ft.
 From ft. to ft. From ft. to ft.

6) GROUT MATERIAL: 1 Neat cement 2 Cement grout 3 Bentonite 4 Other
 Grout intervals: From 5 ft. to 15.5 ft. From 15.5 ft. to 17.5 ft. From ft. to ft.

What is the nearest source of possible contamination:
 1 Septic tank 4 Lateral lines 7 Pit privy 10 Livestock pens 14 Abandoned water well
 2 Sewer lines 5 Cess pool 8 Sewage lagoon 11 Fuel storage 15 Oil well/Gas well
 3 Watertight sewer lines 6 Seepage pit 9 Feedyard 12 Fertilizer storage 16 Other (specify below)
 13 Insecticide storage
 Direction from well? How many feet? 0

FROM	TO	LITHOLOGIC LOG	FROM	TO	PLUGGING INTERVALS
0	0.5	Gravel,			
0.5	3.5	Silt, trace clay, dry, Dark Brown			
3.5	12	Silt, trace clay, damp to moist, Medium Brow			
16	19	Silt, sandy (fine), moist to very moist, Medium			
19	21	Silt, clayey, trace fine sand, Dark Brown			
21	24	Silt, sandy (fine), trace clay, Medium Brown			
24	27	Silt, clayey, trace fine sand, Dark Brown			
27	34.5	Sand, native, fine to coarse grained.			
					VEW5, Flushmount
					Project Name: GT-81 Texaco
					KDHE # AS 015 40055

7) CONTRACTOR'S OR LANDOWNERS CERTIFICATION: This water well was (1) constructed, (2) reconstructed, or (3) plugged under my jurisdiction and was completed on (mo/day/year) 5/4 7/29/2003 and this record is true to the best of my knowledge and belief.
 Kansas Water Well Contractor's License No. 554 This Water Well Record was completed on (mo/day/yr) 4/5/2004
 under the business name of Woofer Pump & Well, Inc by (signature) Guy C. Woofer

OFFICE USE ONLY