


1 LOCATION OF WATER WELL: County: Cloud	Fraction SW 1/4 SE 1/4 NW 1/4	Section Number 32	Township Number T 5 S	Range Number R 3 2
---	---	-----------------------------	---------------------------------	---

Distance and direction from nearest town or city street address of well if located within city?

1/2 mile West of Concordia, Ks.

2 WATER WELL OWNER: Norcan c/o Brown Enviro-Control	Board of Agriculture, Division of Water Resources
RR#, St. Address, Box # : 127 E. 6th	Application Number:
City, State, ZIP Code : Concordia, Kansas 66901	

3 LOCATE WELL'S LOCATION WITH AN "X" IN SECTION BOX:	4 DEPTH OF COMPLETED WELL 53 ft. ELEVATION:
--	--

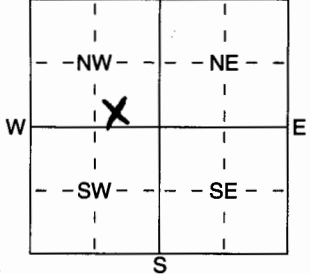

Depth(s) Groundwater Encountered 1 ft. 2 ft. 3 ft.

WELL'S STATIC WATER LEVEL **29** ft. below land surface measured on mo/day/yr **11/10/05**

Pump test data: Well water was ft. after hours pumping gpm

Est. Yield **15-20** gpm: Well water was ft. after hours pumping gpm

WELL WATER TO BE USED AS:

<input checked="" type="checkbox"/> Domestic	3 Feedlot	6 Oil field water supply	9 Dewatering	12 Other (Specify below)
2 Irrigation	4 Industrial	7 Domestic (lawn & garden)	10 Monitoring well	

5 Public water supply 8 Air conditioning 11 Injection well

Was a chemical/bacteriological sample submitted to Department? Yes No ; If yes, mo/day/yr sample was submitted

Water Well Disinfected? Yes No

5 TYPE OF BLANK CASING USED:	5 Wrought iron	8 Concrete tile	CASING JOINTS: Glued <input checked="" type="checkbox"/> Clamped
1 Steel	3 RMP (SR)	6 Asbestos-Cement	9 Other (specify below)
<input checked="" type="checkbox"/> PVC	4 ABS	7 Fiberglass	Welded
TYPE OF SCREEN OR PERFORATION MATERIAL:			
1 Steel	3 Stainless Steel	5 Fiberglass	<input checked="" type="checkbox"/> PVC
2 Brass	4 Galvanized Steel	6 Concrete tile	8 RMP (SR)
SCREEN OR PERFORATION OPENINGS ARE:			
1 Continuous slot	<input checked="" type="checkbox"/> Mill slot	5 Guazed wrapped	8 Saw cut
2 Louvered shutter	4 Key punched	6 Wire wrapped	9 Drilled holes
SCREEN-PERFORATED INTERVALS: From 4.3 ft. to 5.3 ft., From ft. to ft.			
GRAVEL PACK INTERVALS: From 2.7 ft. to 5.3 ft., From ft. to ft.			

6 GROUT MATERIAL:	1 Neat cement	2 Cement grout	3 Bentonite <input checked="" type="checkbox"/>	4 Other
What is the nearest source of possible contamination:				
1 Septic tank	4 Lateral lines	7 Pit privy	10 Livestock pens	14 Abandoned water well
2 Sewer lines	5 Cess pool	8 Sewage lagoon	11 Fuel storage	15 Oil well/Gas well
3 Watertight sewer lines	6 Seepage pit	9 Feedyard	<input checked="" type="checkbox"/> Fertilizer storage	16 Other (specify below)
Direction from well? North			How many feet? 100 ft	

FROM	TO	LITHOLOGIC LOG	FROM	TO	PLUGGING INTERVALS
0	3	Topsoil			
3	11	Clay, brown			
11	28	Clay, tan/silty			
28	40	Sand, fine to medium , tan			
40	51	Sand, fine to medium, tan			
51	54	Clay, gray			

7 CONTRACTOR'S OR LANDOWNER'S CERTIFICATION: This water well was <input checked="" type="checkbox"/> constructed, (2) reconstructed, or (3) plugged under my jurisdiction and was completed on (mo/day/year) 11/11/05 and this record is true to the best of my knowledge and belief. Kansas Water Well Contractor's Licence No 138 This Water Well Record was completed on (mo/day/yr) 11/15/05 under the business name of Peterson Irrigation, Inc. by (signature) <i>Michael Peterson</i>
--

INSTRUCTIONS: Use typewriter or ball point pen. PLEASE PRESS FIRMLY and PRINT clearly. Please fill in blanks, underline or circle the correct answers. Send top three copies to Kansas Department of Health and Environment, Bureau of Water, Geology Section, 1000 SW Jackson St., Suite 420, Topeka, Kansas 66612-1367. Telephone 785-296-5522. Send one to WATER WELL OWNER and retain one for your records. Fee of \$5.00 for each constructed well.