


**1 LOCATION OF WATER WELL:**  
 County: **Cloud**  
 Fraction: **SW 1/4 SW 1/4 NE 1/4** Section Number: **33** Township Number: **T 5 S** Range Number: **R 3 E/W**

Distance and direction from nearest town or city street address of well if located within city?  
**315 Broadway, Concordia**

**2 WATER WELL OWNER: Farmway Coop, Inc.**  
 RR#, St. Address, Box # : **P.O. Box 568**  
 City, State, ZIP Code : **Beloit, Kansas 67420**  
 Board of Agriculture, Division of Water Resources  
 Application Number:

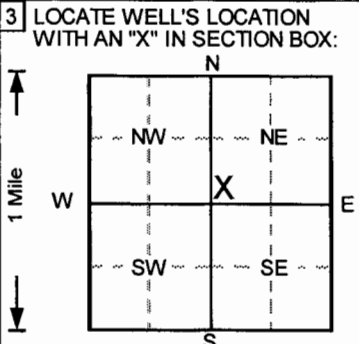

**4 DEPTH OF COMPLETED WELL** . . . . . **30** . . . . . ft. ELEVATION: . . . . .  
 Depth(s) Groundwater Encountered 1. . . . . ft. 2. . . . . ft. 3. . . . . ft.  
 WELL'S STATIC WATER LEVEL . . . . . ft. below land surface measured on mo/day/yr . . . . .  
 Pump test data: Well water was . . . . . **NA** . . . . . ft. after . . . . . hours pumping . . . . . gpm  
 Est. Yield . . . **NA** . . . gpm: Well water was . . . . . ft. after . . . . . hours pumping . . . . . gpm  
 Bore Hole Diameter . . . **8** . . . in. to . . . . . **30** . . . . . ft., and . . . . . in. to . . . . . ft.  
 WELL WATER TO BE USED AS: 5 Public water supply 8 Air conditioning 11 Injection well  
 1 Domestic 3 Feedlot 6 Oil field water supply 9 Dewatering 12 Other (Specify below)  
 2 Irrigation 4 Industrial 7 Lawn and garden only **10** Monitoring well  
 Was a chemical/bacteriological sample submitted to Department? Yes.....No ; If yes, mo/day/yr sample was submitted  
 Water Well Disinfected? Yes No

**5 TYPE OF BLANK CASING USED:**  
 1 Steel 3 RMP (SR) 6 Asbestos-Cement 8 Concrete tile  
**2** PVC 4 ABS 7 Fiberglass  
 Blank casing diameter . . . . . **2** . . . . . in. to . . . . . **10** . . . . . ft, Dia . . . . . in. to . . . . . ft, Dia . . . . . in. to . . . . . ft.  
 Casing height above land surface . . . . . **0** . . . . . in, weight . . . . . lbs./ft. Wall thickness or gauge No. . . . . **Sch. 40**  
 TYPE OF SCREEN OR PERFORATION MATERIAL  
 1 Steel 3 Stainless steel 5 Fiberglass **7** PVC 10 Asbestos-cement  
 2 Brass 4 Galvanized steel 6 Concrete tile 8 RMP (SR) 11 Other (specify)  
 SCREEN OR PERFORATION OPENINGS ARE:  
 1 Continuous slot **3** Mill slot 5 Gauzed wrapped 8 Saw cut 11 None (open hole)  
 2 Louvered shutter 4 Key punched 6 Wire wrapped 9 Drilled holes  
 7 Torch cut 10 Other (specify)  
 SCREEN-PERFORATED INTERVALS: From . . . . . **10** . . . . . ft. to . . . . . **30** . . . . . ft, From . . . . . ft. to . . . . . ft.  
 From . . . . . ft. to . . . . . ft, From . . . . . ft. to . . . . . ft.  
 GRAVEL PACK INTERVALS: From . . . . . **8** . . . . . ft. to . . . . . **30** . . . . . ft, From . . . . . ft. to . . . . . ft.  
 From . . . . . ft. to . . . . . ft, From . . . . . ft. to . . . . . ft.

**6 GROUT MATERIAL:** 1 Neat cement **2** Cement grout **3** Bentonite 4 Other . . . . .  
 Grout Intervals: From . . . . . **0** . . . . . ft. to . . . . . **1** . . . . . ft, From . . . . . **1** . . . . . ft. to . . . . . **8** . . . . . ft, From . . . . . ft. to . . . . . ft.  
 What is the nearest source of possible contamination:  
 1 Septic tank 4 Lateral lines 7 Pit privy 10 Livestock pens 14 Abandoned water well  
 2 Sewer lines 5 Cess pool 8 Sewage lagoon 11 Fuel storage 15 Oil well/Gas well  
 3 Watertight sewer lines 6 Seepage pit 9 Feedyard 12 Fertilizer storage 16 Other (specify below)  
 13 Insecticide storage  
 Direction from well? How many feet?

FROM	TO	LITHOLOGIC LOG	FROM	TO	PLUGGING INTERVALS
0	0.5	Concrete,			
0.5	2	Clay, moist, plastic, no odor, Dark Gray			
2	4.5	Clay with concrete and brick debris,			
4.5	7	Clay, silty, moist, plastic, odor,			
7	8.5	Clay, v. silty, moist, plastic, sl. odor, Gray			
8.5	16	Clay, silty, moist, plastic, no odor, Dark Gray			
16	20	Clay, v. silty, v. moist, v. plastic, no odor, Lt.			
20	22	Clay, sandy, v. moist, no odor, Lt. Gray-Brow			
22	28	Sand (vf-f), saturated, no odor, Lt. Gray-Brow			
28	30	Sand (vf-c), saturated, no odor, Brown			
					MW5R, Tag # 0041387, Flushmount
					Project Name: Farmway Coop, Inc. - Monitoring
					GeoCore # 659, KDHE # U5 015 11247

**7 CONTRACTOR'S OR LANDOWNER'S CERTIFICATION:** This water well was **1** constructed, **(2)** reconstructed, or **(3)** plugged under my jurisdiction and was completed on (mo/day/year) . . . . . **4/10/2007** . . . . . and this record is true to the best of my knowledge and belief. Kansas Water Well Contractor's License No. . . . . **527** . . . . . This Water Well Record was completed on (mo/day/yr) . . . . . **4/17/2007** . . . . . under the business name of **GeoCore, Inc.** by (signature) *Dan a Kel*