


WATER WELL RECORD Form WWC-5 KSA 82a-1212

Table with 4 columns: LOCATION OF WATER WELL: (County: Cloud), Fraction (SW 1/4, SW 1/4, NE 1/4), Section Number (33), Township Number (T 5 S), Range Number (R 3 E/W).

Distance and direction from nearest town or city street address of well if located within city? 315 Broadway, Concordia

2 WATER WELL OWNER: Farmway Coop, Inc. RR#, St. Address, Box # : P.O. Box 568 Board of Agriculture, Division of Water Resources City, State, ZIP Code : Beloit, Kansas 67420 Application Number:

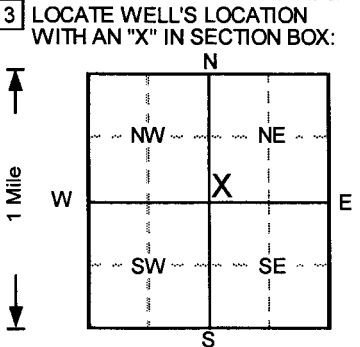

4 DEPTH OF COMPLETED WELL . . . . . 30 . . . . . ft. ELEVATION: . . . . . Depth(s) Groundwater Encountered 1. . . . . ft. 2. . . . . ft. 3. . . . . ft. WELL'S STATIC WATER LEVEL . . . . . ft. below land surface measured on mo/day/yr Pump test data: Well water was . . . . . NA . . . . . ft. after . . . . . hours pumping . . . . . gpm Est. Yield . . . . . NA . . . . . gpm: Well water was . . . . . ft. after . . . . . hours pumping . . . . . gpm Bore Hole Diameter . . . . . 8 . . . . . in. to . . . . . 30 . . . . . ft., and . . . . . in. to . . . . . ft. WELL WATER TO BE USED AS: 5 Public water supply 8 Air conditioning 11 Injection well 1 Domestic 3 Feedlot 6 Oil field water supply 9 Dewatering 12 Other (Specify below) 2 Irrigation 4 Industrial 7 Lawn and garden only 10 Monitoring well Was a chemical/bacteriological sample submitted to Department? Yes.....No✓ ; If yes, mo/day/yr sample was submitted Water Well Disinfected? Yes No ✓

5 TYPE OF BLANK CASING USED: 1 Steel 3 RMP (SR) 6 Asbestos-Cement 8 Concrete tile 9 Other (specify below) CASING JOINTS: Glued . . . . . Clamped . . . . . 2 PVC 4 ABS 7 Fiberglass Welded . . . . . Threaded. ✓ Blank casing diameter . . . . . 2 . . . . . in. to . . . . . 10 . . . . . ft., Dia . . . . . in. to . . . . . ft., Dia . . . . . in. to . . . . . ft. Casing height above land surface . . . . . 0 . . . . . in., weight . . . . . lbs./ft. Wall thickness or gauge No. . . . . Sch. 40 TYPE OF SCREEN OR PERFORATION MATERIAL 1 Steel 3 Stainless steel 5 Fiberglass 7 PVC 10 Asbestos-cement 2 Brass 4 Galvanized steel 6 Concrete tile 8 RMP (SR) 11 Other (specify) . . . . . 12 None used (open hole) SCREEN OR PERFORATION OPENINGS ARE: 1 Continuous slot 3 Mill slot 5 Gauzed wrapped 8 Saw cut 11 None (open hole) 2 Louvered shutter 4 Key punched 6 Wire wrapped 9 Drilled holes 10 Other (specify) . . . . . 7 Torch cut SCREEN-PERFORATED INTERVALS: From . . . . . 10 . . . . . ft. to . . . . . 30 . . . . . ft., From . . . . . ft. to . . . . . ft. From . . . . . ft. to . . . . . ft., From . . . . . ft. to . . . . . ft. GRAVEL PACK INTERVALS: From . . . . . 8 . . . . . ft. to . . . . . 30 . . . . . ft., From . . . . . ft. to . . . . . ft. From . . . . . ft. to . . . . . ft., From . . . . . ft. to . . . . . ft.

6 GROUT MATERIAL: 1 Neat cement 2 Cement grout 3 Bentonite 4 Other . . . . . Grout Intervals: From . . . . . 0 . . . . . ft. to . . . . . 1 . . . . . ft., From . . . . . 1 . . . . . ft. to . . . . . 8 . . . . . ft., From . . . . . ft. to . . . . . ft. What is the nearest source of possible contamination: 1 Septic tank 4 Lateral lines 7 Pit privy 10 Livestock pens 14 Abandoned water well 2 Sewer lines 5 Cess pool 8 Sewage lagoon 11 Fuel storage 15 Oil well/Gas well 3 Watertight sewer lines 6 Seepage pit 9 Feedyard 12 Fertilizer storage 16 Other (specify below) 13 Insecticide storage . . . . . Direction from well? How many feet?

Table with 6 columns: FROM, TO, LITHOLOGIC LOG, FROM, TO, PLUGGING INTERVALS. Contains log data from 0 to 30 feet depth.

MW6, Tag # 0041386, Flushmount Project Name: Farmway Coop, Inc. - Monitoring GeoCore # 659, KDHE # US 015 11247

7 CONTRACTOR'S OR LANDOWNER'S CERTIFICATION: This water well was (1) constructed, (2) reconstructed, or (3) plugged under my jurisdiction and was completed on (mo/day/year) . . . . . 4/10/2007 . . . . . and this record is true to the best of my knowledge and belief. Kansas Water Well Contractor's License No. . . . . 527 . . . . . This Water Well Record was completed on (mo/day/yr) . . . . . 4/17/07 . . . . . under the business name of GeoCore, Inc. by (signature) Dae [Signature]