

CORRECTED

WATER WELL PLUGGING RECORD

Form WWC-5P

KSA 82a-1212

ID NO. _____

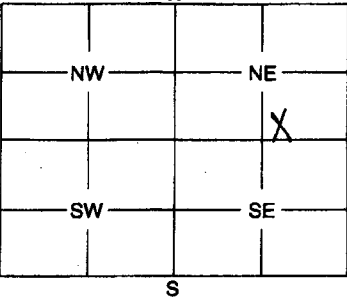
1	LOCATION OF WATER WELL:	Fraction	Section Number	Township Number	Range Number
County:	Cloud	SW $\frac{1}{4}$ SE $\frac{1}{4}$ NE $\frac{1}{4}$	32	5 S	3 E/W

Distance and direction from nearest town or city street address of well if located within city?
803 W. 4th, Concordia

2	WATER WELL OWNER: Union Pacific Railroad
RR #, St. Address, Box #: 1416 Dodge Street, Room 930	Board of Agriculture, Division of Water Resources
City, State, ZIP Code : Omaha, NE 68179	Application Number:

3	MARK WELL'S LOCATION WITH AN "X" IN SECTION BOX:	4	DEPTH OF WELL 38 ft. WELL'S STATIC WATER LEVEL N/A ft. WELL WAS USED AS: 1 Domestic 2 Irrigation 3 Feedlot 4 Industrial 5 Public Water Supply 6 Oil Field Water Supply 7 Domestic (Lawn & Garden) 8 Air Conditioning 9 Dewatering 10 Monitoring Well 11 Injection Well 12 Other
---	--------------------------------------------------	---	---

Was a chemical / bacteriological sample submitted to Department? Yes No
If yes, mo/day/yr sample was submitted

Water Well Disinfected: Yes No


5	TYPE OF BLANK CASING USED:
1 Steel ● PVC	3 RMP (SR) 4 ABS 6 Asbestos-Cement
5 Wrought 7 Fiberglass	9 Other (Specify below)
Blank casing diameter 2 .. in.	Was casing pulled? Yes No If yes, how much 38'
Casing height above or below land surface	

6	GROUT PLUG MATERIAL: 1 Neat cement 2 Cement grout ● Bentonite 4 Other
Grout Plug Intervals: From 1 ft. to 28 ... ft., From ft. to ft., From to ft.	
What is the nearest source of possible contamination:	
1 Septic tank 2 Sewer lines 3 Watertight sewer lines 4 Lateral lines 5 Cess pool	6 Seepage pit 7 Pit privy 8 Sewage lagoon 9 Feedyard 10 Livestock pens
	11 Fuel storage 12 Fertilizer storage 13 Insecticide storage 14 Abandoned water well 15 Oil well/Gas well
Direction from well?	How many feet?

FROM	TO	PLUGGING MATERIALS
1	3	Bentonite (8")
3	28	Bentonite (2")

MW4

KDHE #A5 015 40015

GeoCore #1202

CORRECTED

7	CONTRACTOR'S OF LANDOWNER'S CERTIFICATION: This water well was plugged under my jurisdiction and was completed on (mo/day/year) 9/4/2007 and this record is true to the best of my knowledge and belief. Kansas Water Well Contractor's License No. 527 This Water Well Record was completed on (mo/day/year) 9/10/2007 under the business name of GeoCore, Inc. by (signature) <i>Dan Bell</i>
---	---

INSTRUCTIONS: Use typewriter or ball point pen. Please press firmly and print clearly. Please fill in blanks, underline or circle the correct answers. Send top three copies to Kansas Department of Health and Environment, Bureau of Water, Geology Section, 1000 SW Jackson St., Ste. 420, Topeka, Kansas 66612-1367. Telephone: 785/296-5522. Send one to Water Well Owner and retain one for your records.