

WATER WELL RECORD

Form WWC-5


Division of Water Resources App. No.

1 LOCATION OF WATER WELL: County: Cloud Fraction NE 1/4 NE 1/4 SW 1/4 NE 1/4 Section Number 8 Township No. T 5 S Range Number R 3 [] E [x] W

Street/Rural Address of Well Location; if unknown, distance & direction from nearest town or intersection: If at owner's address, check here [] 4 miles North & 1 miles West of Concordia, Ks.

Global Positioning System (GPS) information: Latitude: .39,634210 Longitude: 97.675086 Elevation: 1405 Datum: [] WGS 84, [x] NAD 83, [] NAD 27 Collection Method: [x] GPS unit, [] Digital Map/Photo, [] Topographic Map, [] Land Survey Est. Accuracy: [] <3 m, [] 3-5 m, [] 5-15 m, [] >15 m

2 WATER WELL OWNER: Charles Sjogren RR#, Street Address, Box #: 1305 Vale Rd. City, State, ZIP Code : Concordia, Kansas 66901

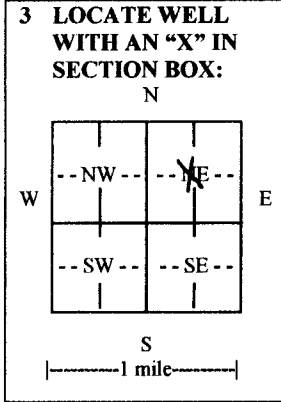

4 DEPTH OF COMPLETED WELL .80 ft. Depth(s) Groundwater Encountered (1)..... ft. (2)..... ft. (3)..... ft. WELL'S STATIC WATER LEVEL .53 ft. below land surface measured on mo/day/yr. 12/8/2015 Pump test data: Well water was.....ft. after..... hours pumping..... gpm EST. YIELD. 20-30 gpm. Well water was.....ft. after..... hours pumping..... gpm Bore Hole Diameter 18 in. to 80 ft., and..... in. to..... ft. WELL WATER TO BE USED AS: [] Public water supply [] Geothermal [] Injection well [] Domestic [] Feedlot [] Oil field water supply [] Dewatering [x] Other (Specify below) [] Irrigation [] Industrial [] Domestic-lawn & garden [] Monitoring well Stock Was a chemical/bacteriological sample submitted to Department? [] Yes [x] No If yes, mo/day/yr sample was submitted..... Water well disinfected? [x] Yes [] No

5 TYPE OF CASING USED: [] Steel [x] PVC [] Other CASING JOINTS: [x] Glued [] Clamped [] Welded [] Threaded Casing diameter .6 in. to 60 ft., Diameter..... in. to..... ft., Diameter..... in. to..... ft. Casing height above land surface 12 in., Weight 3.36 lbs./ft., Wall thickness or gauge No. 0.255 TYPE OF SCREEN OR PERFORATION MATERIAL: [] Steel [] Stainless Steel [x] PVC [] Other (Specify) [] Brass [] Galvanized Steel [] None used (open hole) SCREEN OR PERFORATION OPENINGS ARE: [] Continuous slot [x] Mill slot [] Gauze wrapped [] Torch cut [] Drilled holes [] None (open hole) [] Louvered shutter [] Key punched [] Wire wrapped [] Saw cut [] Other (specify) SCREEN-PERFORATED INTERVALS: From .60 ft. to .80 ft., From..... ft. to..... ft. GRAVEL PACK INTERVALS: From .20 ft. to .80 ft., From..... ft. to..... ft.

6 GROUT MATERIAL: [] Neat cement [] Cement grout [x] Bentonite [] Other Grout Intervals: From 0 ft. to 20 ft., From..... ft. to..... ft., From..... ft. to..... ft. What is the nearest source of possible contamination: [] Septic tank [] Lateral lines [] Pit privy [] Livestock pens [] Insecticide storage [] Other (specify below) [] Sewer lines [] Cesspool [] Sewage lagoon [] Fuel storage [] Abandoned water well [] Watertight sewer lines [] Seepage pit [] Feedyard [] Fertilizer storage [] Oil well/gas well Direction from well None within 1/4 mile Distance from well.....

Table with columns: FROM, TO, LITHOLOGIC LOG, FROM, TO, LITHO. LOG (cont.) or PLUGGING INTERVALS. Rows include Topsoil, Clay, tan, Limestone- loose w/clay 50/50, Shale, gray, soft, Sandstone rock, soft, Shale, hard/gray.

7 CONTRACTOR'S OR LANDOWNER'S CERTIFICATION: This water well was [x] constructed, [] reconstructed, or [] plugged under my jurisdiction and was completed on (mo/day/year) 12/8/2015 and this record is true to the best of my knowledge and belief. Kansas Water Well Contractor's License No. 897 This Water Well Record was completed on (mo/day/year) 12/14/2015 under the business name of Peterson McNett Drilling, Inc. by (signature) [Signature]

INSTRUCTIONS: Use typewriter or ball point pen. PLEASE PRESS FIRMLY and PRINT clearly. Please fill in blanks and check the correct answers. Send one copy to Kansas Department of Health and Environment, Bureau of Water, Geology Section, 1000 SW Jackson St., Suite 420, Topeka, Kansas 66612-1367. Telephone 785-296-5524. Send one copy to WATER WELL OWNER and retain one for your records. Include fee of \$5.00 for each constructed well. Visit us at