

WATER WELL RECORD

Form WWC-5

Division of Water Resources App. No.


49,124

1 LOCATION OF WATER WELL: County: Cloud	Fraction SW ¼ SE ¼ SW ¼ SW ¼	Section Number 8	Township No. T 5 S	Range Number R 3 <input type="checkbox"/> E <input checked="" type="checkbox"/> W
---	---------------------------------	---------------------	-----------------------	--

Street/Rural Address of Well Location; if unknown, distance & direction from nearest town or intersection: If at owner's address, check here .
3 1/2 miles North & 2 1/2 miles West of Concordia, Ks.

Global Positioning System (GPS) information:
 Latitude: 39.62438304 (in decimal degrees)
 Longitude: 97.6851433 (in decimal degrees)
 Elevation: 1405
 Datum: WGS 84, NAD 83, NAD 27
 Collection Method:
 GPS unit (Make/Model:)
 Digital Map/Photo, Topographic Map, Land Survey
 Est. Accuracy: <3 m, 3-5 m, 5-15 m, >15 m

2 WATER WELL OWNER: Charles Sioqren
 RR#, Street Address, Box #: 1305 Vale Rd.
 City, State, ZIP Code : Concordia, Kansas 66901

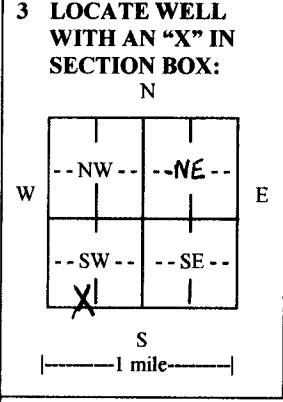

4 DEPTH OF COMPLETED WELL 94 ft.

Depth(s) Groundwater Encountered (1)..... ft. (2)..... ft. (3)..... ft.

WELL'S STATIC WATER LEVEL 61 ft. below land surface measured on mo/day/yr. 12/3/2015

Pump test data: Well water was..... ft. after..... hours pumping..... gpm

EST. YIELD. 400 gpm. Well water was..... ft. after..... hours pumping..... gpm

Bore Hole Diameter 30 in. to 94 ft., and in. to ft.

WELL WATER TO BE USED AS: Public water supply Geothermal Injection well
 Domestic Feedlot Oil field water supply Dewatering Other (Specify below)
 Irrigation Industrial Domestic-lawn & garden Monitoring well

Was a chemical/bacteriological sample submitted to Department? Yes No

If yes, mo/day/yr sample was submitted.....

Water well disinfected? Yes No

5 TYPE OF CASING USED: Steel PVC Other

CASING JOINTS: Glued Clamped Welded Threaded

Casing diameter 16 in. to 54 ft., Diameter in. to ft., Diameter in. to ft.

Casing height above land surface 12 in., Weight 16.15 lbs./ft., Wall thickness or gauge No. 0.500

TYPE OF SCREEN OR PERFORATION MATERIAL:
 Steel Stainless Steel PVC Other (Specify)
 Brass Galvanized Steel None used (open hole)

SCREEN OR PERFORATION OPENINGS ARE:
 Continuous slot Mill slot Gauze wrapped Torch cut Drilled holes None (open hole)
 Louvered shutter Key punched Wire wrapped Saw cut Other (specify)

SCREEN-PERFORATED INTERVALS: From 54 ft. to 94 ft., From ft. to ft.
 From ft. to ft., From ft. to ft.

GRAVEL PACK INTERVALS: From 30 ft. to 94 ft., From ft. to ft.
 From ft. to ft., From ft. to ft.

6 GROUT MATERIAL: Neat cement Cement grout Bentonite Other

Grout Intervals: From 0 ft. to 30 ft., From ft. to ft., From ft. to ft.

What is the nearest source of possible contamination:
 Septic tank Lateral lines Pit privy Livestock pens Insecticide storage Other (specify below)
 Sewer lines Cesspool Sewage lagoon Fuel storage Abandoned water well
 Watertight sewer lines Seepage pit Feedyard Fertilizer storage Oil well/gas well

Direction from well West Distance from well 1/8 mile

FROM	TO	LITHOLOGIC LOG	FROM	TO	LITHO. LOG (cont.) or PLUGGING INTERVALS
0	3	Topsoil			
3	52	Clay, tan			
52	61	Sand w/clay layers 60/40			
61	77	Sand, medium to coarse			
77	79	Clay layer			
79	92	Sand, medium			
92	94	Clay, tan			

7 CONTRACTOR'S OR LANDOWNER'S CERTIFICATION: This water well was constructed, reconstructed, or plugged under my jurisdiction and was completed on (mo/day/year) 12/3/2015 and this record is true to the best of my knowledge and belief. Kansas Water Well Contractor's License No. 897 This Water Well Record was completed on (mo/day/year) 12/14/2015 under the business name of Peterson McNett Drilling, Inc. by (signature) [Signature]

INSTRUCTIONS: Use typewriter or ball point pen. PLEASE PRESS FIRMLY and PRINT clearly. Please fill in blanks and check the correct answers. Send one copy to Kansas Department of Health and Environment, Bureau of Water, Geology Section, 1000 SW Jackson St., Suite 420, Topeka, Kansas 66612-1367. Telephone 785-296-5524. Send one copy to WATER WELL OWNER and retain one for your records. Include fee of \$5.00 for each constructed well. Visit us at