

WATER WELL PLUGGING RECORD Form WWC-5P

KSA 82a-1212

ID NO.

1 LOCATION OF WATER WELL:	Fraction	Section Number	Township Number	Range Number
County: <u>Cloud</u>	<u>NE 1/4</u> 1/4 1/4 1/4	<u>21</u>	<u>T5</u> S	<u>3</u> <input type="checkbox"/> E <input checked="" type="checkbox"/> W

Street/Rural Address of Well Location; if unknown, distance & direction from nearest town or intersection: If at owner's address, check here ☒

2087 N. 150th

Global Positioning Systems (GPS) information:

Latitude: _____ (in decimal degrees)

Longitude: _____ (in decimal degrees)

Elevation: _____

Datum: ☐ WGS84, ☐ NAD83, ☐ NAD27

Collection Method:


☐ GPS unit (Make/Model: _____)

☐ Digital Map/Photo, ☐ Topographic Map, ☐ Land Survey

Est. Accuracy: ☐ < 3 m, ☐ 3-5 m, ☐ 5-15 m, ☐ > 15 m

2 WATER WELL OWNER: Matthew Carder
RR#, St. Address, Box #: 2087 N 150th Rd
City, State ZIP Code: Concordia, KS 66901

3 MARK WELL'S LOCATION WITH AN "X" IN SECTION BOX:

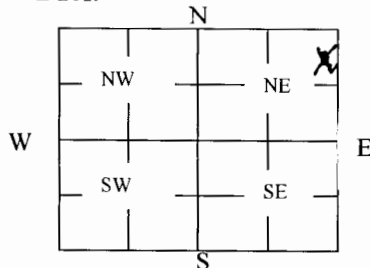

4 DEPTH OF WELL 30 ft.

WELL'S STATIC WATER LEVEL 29.8 ft

WELL WAS USED AS:

☒ Domestic
☐ Irrigation
☐ Feedlot
☐ Industrial

☐ Public Water Supply
☐ Oil Field Water Supply
☐ Domestic (Lawn & Garden)
☐ Air Conditioning

☐ Dewatering
☐ Monitoring
☐ Injection Well
☐ Other _____

Was a chemical/bacteriological sample submitted to Department? Yes ☐ No ☐

5 TYPE OF BLANK CASING USED:

☐ Steel
☒ PVC

☐ RMP (SR)
☐ ABS

☐ Wrought
☐ Asbestos-Cement

☐ Fiberglass
☐ Concrete Tile

☐ Other (Specify below) _____

Blank casing diameter 6 in. Was casing pulled? Yes ☐ No ☒ If yes, how much _____

Casing height above or below land surface 6 in in.

6 GROUT PLUG MATERIAL: ☐ Neat cement ☐ Cement grout ☒ Bentonite ☐ Other _____

Grout Plug Intervals: From _____ ft. to _____ ft., From _____ ft. to _____ ft., From _____ ft. to _____ ft.

What is the nearest source of possible contamination:

☐ Septic tank
☐ Sewer lines
☐ Watertight sewer lines
☒ Lateral lines
☐ Cess pool

☐ Seepage pit
☐ Pit privy
☐ Sewage lagoon
☐ Feedyard
☐ Livestock pens

☐ Fuel storage
☐ Fertilizer storage
☐ Insecticide storage
☐ Abandoned water well
☐ Oil well/Gas well

☐ Other (specify below) _____

Direction from well? OLD WEST - 20-30H
How many feet? _____

FROM	TO	PLUGGING MATERIALS	FROM	TO	PLUGGING MATERIALS
30-	28	gravel (sand) + cloring			
28	26.5	bentonite			
26.5	14.5	soil - loam			
4.2	2	bentonite			
2	0	soil loam			

7 CONTRACTOR'S OR LANDOWNER'S CERTIFICATION: This water well was plugged under my jurisdiction and was completed on (mo/day/year) 8/15/17 and this record is true to the best of my knowledge and belief. Kansas Water Well Contractor's License No. _____. This Water Well Record was completed on (mo/day/year) _____ under the business name of Hay Creek LLC by (signature) _____

INSTRUCTIONS: Use typewriter or ballpoint pen. Please press firmly and print clearly. Please fill in blanks, underline or circle the correct answers. Send top three copies to Kansas Department of Health and Environment, Bureau of Water, Geology Section, 1000 SW Jackson St., Ste. 420, Topeka, Kansas 66612-1367. Telephone: 785/296-5524. Send one to Water Well Owner and retain one for your records. Visit us at <http://www.kdheks.gov/waterwell/index.html>.

**NPS POLLUTION CONTROL FUNDS
ABANDONED WATER WELL COST-SHARE PROGRAM
(WELL PLUGGING WORKSHEET)**

WORKSHEET: (Use water quality bulletin to complete this worksheet, available through Cooperative Extension Service)

Name: MATT CARDER County: CLOUD Date: August 16, 2017

Type of Well: Drilled: X Hand dug:

Diameter (Inside): 6 in Diameter (Outside): 7 in Depth to Water: 29.8 Total Depth: 30 ft

TOP SOIL: 3 ft

TOP SOIL NEEDED:

$$\underline{0.27} \text{ cu.ft/ft} \times \underline{3} \text{ ft} = \underline{0.8} \text{ cu.ft}$$

$$\underline{0.8} \text{ cu.ft} \times 1 \text{ cu.yd/27 cu.ft} = \underline{0.0} \text{ cu.yds}$$

BENTONITE PLUG: 1.5 ft

BENTONITE NEEDED:

$$\text{PLUG: } \underline{0.27} \text{ cu.ft/ft} \times \underline{1.5} \text{ ft} = \underline{0.4} \text{ cu.ft}$$

$$\text{GROUT SEAL RESTORATION: } \underline{0.0} \text{ cu.ft}$$

$$\underline{0.4} \text{ cu.ft} \times 1 \text{ bag/0.7 cu.ft} = \underline{0.6} \text{ bags}$$

SUBSOIL: 25.3 ft

SUBSOIL NEEDED:

$$\underline{0.20} \text{ cu.ft/ft} \times \underline{25.3} \text{ ft} = \underline{5.0} \text{ cu.ft}$$

$$\underline{5.0} \text{ cu.ft} \times 1 \text{ cu.yd/27 cu.ft} = \underline{0.2} \text{ cu.yds}$$

SAND (to water level): 0.2 ft

SAND NEEDED:

$$\underline{0.20} \text{ cu.ft/ft} \times \underline{0.2} \text{ ft} = \underline{0.0} \text{ cu.ft}$$

$$\underline{0.0} \text{ cu.ft} \times 1 \text{ cu.yd/27 cu.ft} = \underline{0.0} \text{ cu.yds}$$

CHLORINE NEEDED - Liquid (5.25%):

$$\underline{1.79} \text{ oz/ft} \times \underline{0.2} \text{ ft} = \underline{0.4} \text{ oz}$$

$$\underline{0.4} \text{ oz} \times 1 \text{ gal/128 oz} = \underline{0.0} \text{ gal}$$

SITE PREPARATION: REMOVE PUMP AND COLUMN PIPE AND DEBRIS. EXCAVATE AROUND DRILLED WELL CASING AND CUT CASING 3 FEET BELOW GROUND LEVEL. STOCKPILE FILL MATERIAL ON SITE. LEAVE IN TRUCK IF POSSIBLE. HANDDUG WELLS NEED TRACTOR WITH FRONT END LOAD OR LARGE PRY BARS TO CAVE IN ROCK LINING.