


1 LOCATION OF WATER WELL: Fraction NW 1/4 SW 1/4 NE 1/4 Section Number 22 Township Number J 5 S Range Number R 3W E/W
 County: Cloud
 Distance and Direction from nearest town or city street address of well if located within city? approx. 3960' North & 2050' West of the S.E. corner of said Section
 1 Mile West, 2 1/2 Miles North of Concordia

2 WATER WELL OWNER: Leland Snavelly
 RR#, St. Address, Box #: Rt. 2 Board of Agriculture, Division of Water Resources
 City, State, ZIP Code: Concordia, Ks. 66901 Application Number: 35,114

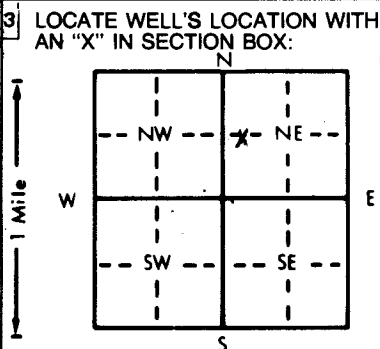

4 DEPTH OF COMPLETED WELL: 43' ft. ELEVATION: 13.50
 Depth(s) Groundwater Encountered 1. 23' ft. 2. ft. 3. ft.
 WELL'S STATIC WATER LEVEL 18' ft. below land surface measured on mo/day/yr 7-20-81
 Pump test data: Well water was 43' ft. after 1 hours pumping 500 gpm
 Est. Yield 500/800 gpm: Well water was ft. after hours pumping gpm
 Bore Hole Diameter 32" in. to 43' ft. and in. to ft.
 WELL WATER TO BE USED AS: 5 Public water supply 8 Air conditioning 11 Injection well
 1 Domestic 3 Feedlot 6 Oil field water supply 9 Dewatering 12 Other (Specify below)
 X 2 Irrigation 4 Industrial 7 Lawn and garden only 10 Observation well
 Was a chemical/bacteriological sample submitted to Department? Yes.....No...X.....; If yes, mo/day/yr sample was submitted
 Water Well Disinfected? Yes X No

5 TYPE OF CASING USED: 5 Wrought iron 8 Concrete tile CASING JOINTS: Glued.....Clamped X.....
 1 Steel 3 RMP (SR) X 6 Asbestos-Cement 9 Other (specify below) Welded.....
 2 PVC 4 ABS 7 Fiberglass Threaded.....
 Blank casing diameter 16" in. to 17' ft., Dia in. to ft., Dia in. to ft.
 Casing height above land surface 12" in., weight 34 lbs./ft. Wall thickness or gauge No. 3/4"
 TYPE OF SCREEN OR PERFORATION MATERIAL: 7 PVC X 10 Asbestos-cement
 1 Steel 3 Stainless steel 5 Fiberglass 8 RMP (SR) 11 Other (specify).....
 2 Brass 4 Galvanized steel 6 Concrete tile 9 ABS 12 None used (open hole)
 SCREEN OR PERFORATION OPENINGS ARE: 5 Gauzed wrapped X 8 Saw cut 11 None (open hole)
 1 Continuous slot 3 Mill slot 6 Wire wrapped 9 Drilled holes
 2 Louvered shutter 4 Key punched 7 Torch cut 10 Other (specify).....
 SCREEN-PERFORATED INTERVALS: From 17 ft. to 43 ft., From ft. to ft. ft. to ft.
 GRAVEL PACK INTERVALS: From 10 ft. to 43 ft., From ft. to ft. ft. to ft.

6 GROUT MATERIAL: 1 Neat cement X 2 Cement grout 3 Bentonite 4 Other.....
 Grout Intervals: From 0 ft. to 10 ft., From ft. to ft. ft. to ft. ft. to ft.
 What is the nearest source of possible contamination: NONE 10 Livestock pens 14 Abandoned water well
 1 Septic tank 4 Lateral lines 7 Pit privy 11 Fuel storage 15 Oil well/Gas well
 2 Sewer lines 5 Cess pool 8 Sewage lagoon 12 Fertilizer storage 16 Other (specify below)
 3 Watertight sewer lines 6 Seepage pit 9 Feedyard 13 Insecticide storage.....

Direction from well? How many feet?

FROM	TO	LITHOLOGIC LOG	FROM	TO	LITHOLOGIC LOG
0	23	Top Soil & Clay			
23	36	Gravel (good)			
36	42	Gravel (real good)			
42	46	clay			
46	48	SHALE (soft) Yellow Clay			
48	54	Shale (soft)			

7 CONTRACTOR'S OR LANDOWNER'S CERTIFICATION: This water well was (1) constructed, (2) reconstructed, or (3) plugged under my jurisdiction and was completed on (mo/day/year) July 20, 1981 and this record is true to the best of my knowledge and belief. Kansas Water Well Contractor's License No. 361 This Water Well Record was completed on (mo/day/yr) 12-1-81 under the business name of Cox-Beswick Irrigation Service, Inc. by (signature) Francis Cox

INSTRUCTIONS: Use typewriter or ball point pen, PLEASE PRESS FIRMLY and PRINT clearly. Please fill in blanks, underline or circle the correct answers. Send top three copies to Kansas Department of Health and Environment, Division of Environment, Environmental Geology Section, Topeka, KS 66620. Send one to WATER WELL OWNER and retain one for your records.