


USE TYPEWRITER OR BALL POINT PEN-PRESS FIRMLY, PRINT CLEARLY.

WATER WELL RECORD
KSA 82a-1201-1215

Kansas Department of Health and Environment-Division of Environment
(Water well Contractors)
Topeka, Kansas 66620

1. Location of well:		County CLOUD	Fraction NW NE SE 1/4 SW 1/4	Section number 23	Township number T 5 S R 3	Range number EW
2. Distance and direction from nearest town or city: 1 1/2 N - 1 1/2 E			3. Owner of well: Merwin Hayden			
Street address of well location if in city: of Concordia			R.R. or street: City, state, zip code: Concordia, Kansas 66901			
4. Locate with "X" in section below:			Sketch map:		6. Bore hole dia. 30 in. Completion date 1-25-78 Well depth 43 ft.	
					7. <input type="checkbox"/> Cable tool <input type="checkbox"/> Rotary <input type="checkbox"/> Driven <input type="checkbox"/> Dug <input type="checkbox"/> Hollow rod <input type="checkbox"/> Jetted <input type="checkbox"/> Bored <input checked="" type="checkbox"/> Reverse rotary	
5. Type and color of material			From	To	8. Use: <input type="checkbox"/> Domestic <input type="checkbox"/> Public supply <input type="checkbox"/> Industry <input checked="" type="checkbox"/> Irrigation <input type="checkbox"/> Air conditioning <input type="checkbox"/> Stock <input type="checkbox"/> Lawn <input type="checkbox"/> Oil field water <input type="checkbox"/> Other	
top soil			0	7	9. Casing: Material AC Height: Above or below Threaded <input type="checkbox"/> Welded <input type="checkbox"/> Surface 12 in. RMP <input type="checkbox"/> PVC <input type="checkbox"/> Weight 34 lbs./ft. Dia. 16 in. to 43 ft. depth Wall Thickness: inches or Dia. in. to ft. depth gage No. 34"	
sand			7	10	10. Screen: Manufacturer's name Johnson Type transit Dia. 16 Slot/gauze 1/16" Length 26 Set between 19 ft. and 43 ft. ft. and ft. Gravel pack? YES Size range of material 1/8-1/4"	
gravel			10	43	11. Static water level: 11-25-77 mo./day/yr. 9 ft. below land surface Date 11-25-77	
clay			43		12. Pumping level below land surfaces: 15 ft. after 1/2 hrs. pumping 1050 g.p.m. ft. after hrs. pumping g.p.m. Estimated maximum yield 1500 g.p.m.	
					13. Water sample submitted: mo./day/yr. <input type="checkbox"/> Yes <input checked="" type="checkbox"/> No Date	
					14. Well head completion: <input type="checkbox"/> Pitless adapter 12 inches above grade	
					15. Well grouted? YES With: <input type="checkbox"/> Neat cement <input type="checkbox"/> Bentonite <input checked="" type="checkbox"/> Concrete Depth: From 0 ft. to 10 ft.	
					16. Nearest source of possible contamination: NONE ft. Direction Type Well disinfected upon completion? <input type="checkbox"/> Yes <input checked="" type="checkbox"/> No	
					17. Pump: <input checked="" type="checkbox"/> Not installed Manufacturer's name Model number HP Volts Length of drop pipe ft. capacity g.p.m. Type: <input type="checkbox"/> Submersible <input type="checkbox"/> Turbine <input type="checkbox"/> Jet <input type="checkbox"/> Reciprocating <input type="checkbox"/> Centrifugal <input type="checkbox"/> Other	
18. Elevation: 1338			19. Remarks: Grouting concrete done by owner		20. Water well contractor's certification: This well was drilled under my jurisdiction and this report is true to the best of my knowledge and belief. Ger Lloyd Song, Inc 258 Business name License No. Address Clifton, Mo 66937 Signed Francis Cox Date 1-2 Authorized representative	

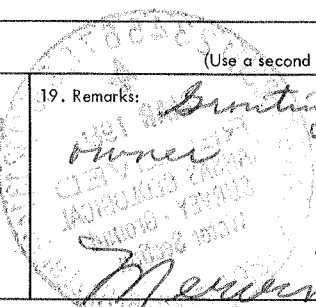

Forward the white, blue and pink copies to the Department of Health and Environment

Form WWC-5

T
R
E
S
E
C
1/4
1/4
1/4