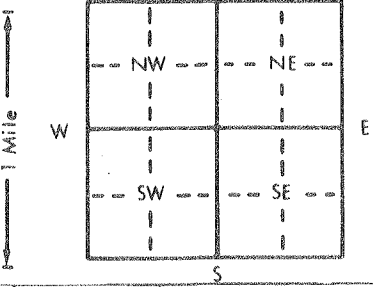


1 LOCATION OF WATER WELL:		Fraction	Section Number	Township Number	Range Number
County: <u>Cloud</u>		<u>SE</u> 1/4 <u>SW</u> 1/4 <u>NW</u> 1/4	<u>28</u>	<u>T</u> <u>5</u> <u>S</u>	<u>R</u> <u>3</u> <u>EW</u>
Distance and direction from nearest town or city street address of well if located within city? <u>1 mile North of Concordia</u>					
2 WATER WELL OWNER: <u>Armound Naileux</u>					
RR#, St. Address, Box # : <u>Rt 1</u>					
City, State, ZIP Code : <u>Concordia, KS 66901</u>					
Board of Agriculture, Division of Water Resources Application Number: <u>40,091</u>					
3 LOCATE WELL'S LOCATION WITH AN "X" IN SECTION BOX:		4 DEPTH OF COMPLETED WELL... <u>56</u> ft. ELEVATION:			
		Depth(s) Groundwater Encountered 1... <u>8</u> ft. 2... .. ft. 3... .. ft.			
		WELL'S STATIC WATER LEVEL ... <u>8</u> ft. below land surface measured on mo/day/yr <u>4-18-94</u>			
		Pump test data: Well water was ... ft. after ... hours pumping ... gpm			
		Est. Yield <u>1,000</u> gpm: Well water was ... ft. after ... hours pumping ... gpm			
		Bore Hole Diameter... <u>30</u> in. to <u>56</u> ft., and ... in. to ... ft.			
WELL WATER TO BE USED AS: 5 Public water supply 8 Air conditioning 11 Injection well					
1 Domestic 3 Feedlot 6 Oil field water supply 9 Dewatering 12 Other (Specify below)					
2 Irrigation 4 Industrial 7 Lawn and garden only 10 Monitoring well					
Was a chemical/bacteriological sample submitted to Department? Yes.....No. <u>X</u>; If yes, mo/day/yr sample was sub-					
mitted Water Well Disinfected? Yes <u>X</u> No					
5 TYPE OF BLANK CASING USED:					
1 Steel 3 RMP (SR) 5 Wrought iron 8 Concrete tile CASING JOINTS: Glued <u>X</u> Clamped					
2 PVC 4 ABS 6 Asbestos-Cement 9 Other (specify below) Welded					
7 Fiberglass Threaded					
Blank casing diameter ... <u>1.6</u> in. to <u>2.6</u> in. Dia ... in. to ... in. Dia ... in. to ... in. to ... ft.					
Casing height above land surface... <u>12</u> in., weight <u>1.6</u> lbs./ft. Wall thickness or gauge No. <u>500</u>					
TYPE OF SCREEN OR PERFORATION MATERIAL:					
1 Steel 3 Stainless steel 5 Fiberglass 7 PVC 10 Asbestos-cement					
2 Brass 4 Galvanized steel 6 Concrete tile 8 RMP (SR) 11 Other (specify)					
9 ABS 12 None used (open hole)					
SCREEN OR PERFORATION OPENINGS ARE:					
1 Continuous slot 3 Mill slot 5 Gauzed wrapped 8 Saw cut 11 None (open hole)					
2 Louvered shutter 4 Key punched 6 Wire wrapped 9 Drilled holes					
7 Torch cut 10 Other (specify)					
SCREEN-PERFORATED INTERVALS: From ... <u>26</u> ft. to <u>56</u> ft. From ... ft. to ... ft.					
From ... ft. to ... ft. From ... ft. to ... ft.					
GRAVEL PACK INTERVALS: From ... <u>20</u> ft. to <u>56</u> ft. From ... ft. to ... ft.					
From ... ft. to ... ft. From ... ft. to ... ft.					

6 GROUT MATERIAL:		1 Neat cement	2 Cement grout	3 Bentonite	4 Other
Grout Intervals: From ... <u>0</u> ft. to <u>20</u> ft., From ... ft. to ... ft., From ... ft. to ... ft.					
What is the nearest source of possible contamination:					
1 Septic tank 4 Lateral lines 7 Pit privy 10 Livestock pens 14 Abandoned water well					
2 Sewer lines 5 Cess pool 8 Sewage lagoon 11 Fuel storage 15 Oil well/Gas well					
3 Watertight sewer lines 6 Seepage pit 9 Feedyard 12 Fertilizer storage 16 Other (specify below)					
13 Insecticide storage					
Direction from well? <u>South</u>		How many feet? <u>1/2 mile</u>			

FROM	TO	LITHOLOGIC LOG	FROM	TO	PLUGGING INTERVALS
0	2	Top Soil-Sandy			
2	8	Very Fine Sand			
8	21	Medium Sand			
21	36	Medium to Course Sand & Gravel			
36	37	Green Clay			
37	49	Course Sand & Gravel			
49	52	Course Sand & Gravel & Green Clay			
52	56	Brown Clay			

7 CONTRACTOR'S OR LANDOWNER'S CERTIFICATION: This water well was (1) constructed, (2) reconstructed, or (3) plugged under my jurisdiction and was completed on (mo/day/year) <u>4-18-94</u> and this record is true to the best of my knowledge and belief. Kansas Water Well Contractor's License No. <u>138</u> This Water Well Record was completed on (mo/day/yr) <u>4-24-94</u> under the business name of <u>Peterson Irrigation Inc.</u> by (signature) <u>Mike Peterson</u>	
---	--