USE TYPEWRITER OR BALL POINT PEN-PRESS FIRMLY, PRINT CLEARLY.

WATER WELL RECORD
KSA 82a-1201-1215

Kansas Department of Health and Environment-Division of Environment
(Water well Contractors)
Topeka, Kansas 66620

1. Location of well:	County	Fraction	Section number	Township number	Range number
	CLOUD	SE 1/4 NW 1/4 SW 1/4	32	T 5 S	R 3 E/W

2. Distance and direction from nearest town or city: 1 WEST
Street address of well location if in city: CONCORDIA

3. Owner of well: JERRY LIBY
R.R. or street: 128 West 9th
City, state, zip code: CONCORDIA, KANS 66901

4. Locate with "X" in section below:

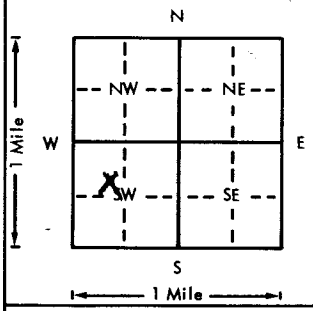

Sketch map:

5. Type and color of material	From	To
TOPSOIL	0	4
BROWN CLAY	4	36
SANDY CLAY	36	42
GRAVEL	42	53
BROWN CLAY	53	59
STOP	59	

(Use a second sheet if needed)

6. Bore hole dia. 8 in. Completion date 5/5/77
Well depth 59 ft.

7. __ Cable tool X Rotary __ Driven __ Dug
__ Hollow rod __ Jetted __ Bored __ Reverse rotary

8. Use: X Domestic __ Public supply __ Industry
__ Irrigation __ Air conditioning __ Stock
__ Lawn __ Oil field water __ Other

9. Casing: Material PVC Height: Above or below
Threaded ___ Welded X Surface 12 in.
RMP ___ PVC X Weight 3 lbs./ft.
Dia. 5 in. to 59 ft. depth Wall Thickness: inches or
Dia. ___ in. to ___ ft. depth gage No. .258

10. Screen: Manufacturer's name PUMPCO
Type PVC Dia. 5"
Slot/gauze 1/16 Length 20'
Set between 39 ft. and 59 ft.
___ ft. and ___ ft.
Gravel pack? YES Size range of material 4x14

11. Static water level: mo./day/yr.
30 ft. below land surface Date 5/5/77

12. Pumping level below land surface:
___ ft. after ___ hrs. pumping ___ g.p.m.
___ ft. after ___ hrs. pumping ___ g.p.m.
Estimated maximum yield 25 g.p.m.

13. Water sample submitted: mo./day/yr.
__ Yes X No Date

14. Well head completion:
__ Pitless adapter 12 inches above grade

15. Well grouted? YES
With: X Neat cement __ Bentonite __ Concrete
Depth: From 0 ft. to 10 ft.

16. Nearest source of possible contamination:
ft. 300 Direction NORTH Type LOTS
Well disinfected upon completion? X Yes __ No

17. Pump: X Not installed
Manufacturer's name
Model number HP Volts
Length of drop pipe ft. capacity g.p.m.
Type:
__ Submersible __ Turbine
__ Jet __ Reciprocating
__ Centrifugal __ Other

18. Elevation: ≈1388
Topography:
__ Hill
__ Slope
✓ Upland
__ Valley

19. Remarks:

20. Water well contractor's certification:
This well was drilled under my jurisdiction and this report is true to the best of my knowledge and belief.
GEO COX + SONS INC 258
Business name License No.
Address CLIFTON KANS 66937
Signed Cheryl Cox Date
Authorized representative 5/5/77

T 5 R 3 E/W Sec 32 1/4 SE 1/4 NW 1/4 SW 1/4

Forward the white, blue and pink copies to the Department of Health and Environment

Form WWC-5

MI-1023