

WATER WELL RECORD  
KSA 82a-1201-1215

Kansas Department of Health and Environment  
Division of Environment  
(Water well Contractors)  
Topeka, Kansas 66620


1. Location of well: **CLoud** County: **CLoud** Fraction: **NE 1/4 NE 1/4 SW 1/4** Section number: **32** Township number: **T 5 S R** Range number: **3 W**

2. Distance and direction from nearest town or city: **1/2 W of Concordia**

3. Owner of well: **VICTOR COLLINS**  
R.R. street: **#2**  
City, state, zip code: **CONCORDIA KANS 66901**

4. Locate with "X" in section below:

Sketch map:

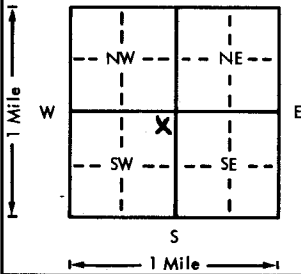

*CAP*

5. Type and color of material

From To

0 -		
Top SOIL + CLAY	0	10
SANDY CLAY	10	23
SAND + GRAVEL	23	46
GRAVEL	46	54

6. Bore hole dia. **8** in. Completion date **11-20-76**  
Well depth **54** ft.

7. Cable tool  Rotary  Driven  Dug  
 Hollow rod  Jetted  Bored  Reverse rotary

8. Use:  Domestic  Public supply  Industry  
 Irrigation  Air conditioning  Stack  
 Lawn  Oil field water  Other

9. Casing: Material **PLASTIC** Height: Above  below   
Threaded  Welded  Surface **12** in.  
RMP  PVC  Weight **3** lbs./ft.  
Dia. **5** in. to **54** ft. depth Wall Thickness: inches or  
Dia.  in. to  ft. depth **1214**

10. Screen: Manufacturer's name **PUMPCO**  
Type **PVC** Dia. **5"**  
Slot/gauge **1/16"** Length **10'**  
Set between **44** ft. and **54** ft.  
Gravel pack? **YES** Size range of material **40-44** ft.

11. Static water level:  mo./day/yr.  
**28** ft. below land surface Date **11-20-76**

12. Pumping level below land surfaces:  
 ft. after  hrs. pumping  g.p.m.  
 ft. after  hrs. pumping  g.p.m.  
Estimated maximum yield  g.p.m.

13. Water sample submitted:  mo./day/yr.  
Yes  No Date

14. Well head completion:  
 Pitless adapter **12** Inches above grade

15. Well grouted? **YES**  
With:  Neat cement  Bentonite  Concrete  
Depth: From **0** ft. to **10** ft.

16. Nearest source of possible contamination: **NONE**  
ft.  Direction  Type   
Well disinfected upon completion?  Yes  No

17. Pump:  Not installed  
Manufacturer's name   
Model number  HP  Volts   
Length of drop pipe  ft. capacity  g.p.m.  
Type:  
 Submersible  Turbine  
 Jet  Reciprocating  
 Centrifugal  Other

18. Elevation:

19. Remarks:

Topography:  
 Hill  
 Slope  
 Upland  
 Valley

20. Water well contractor's certification:  
This well was drilled under my jurisdiction and this report is true to the best of my knowledge and belief.  
**GEO COX & SONS, INC 2587**  
Business name License No.  
Address **CLIFTON KANSAS 66937**  
Signed **Juanita Cox** Date **11-23-76**  
Authorized representative

Forward the white, blue and pink copies to the Department of Health and Environment

Form WWC-5

5  
 3  
 3  
 2  
 1/2  
 NE NE SW