


1 LOCATION OF WATER WELL: County: CLOUD Fraction: NE 1/4 SE 1/4 NE 1/4 Section Number: 32 Township Number: T 05 S Range Number: R 03 E 01

Distance and direction from nearest town or city street address of well if located within city?

CITY of CONCORDIA,

2 WATER WELL OWNER: Glen Brown - KDHE MW # 3
 RR#, St. Address, Box #: Rt 1
 City, State, ZIP Code: Concordia, KS 66901
 Board of Agriculture, Division of Water Resources
 Application Number:

3 LOCATE WELL'S LOCATION WITH AN "X" IN SECTION BOX:
 4 DEPTH OF COMPLETED WELL: 52.7 ft. ELEVATION: 1366.122 900
 Depth(s) Groundwater Encountered 1. 25 ft. 2. 43 ft. 3. _____ ft.
 WELL'S STATIC WATER LEVEL: 22.20 ft. below land surface measured on mo/day/yr 10/22/87
 Pump test data: Well water was _____ ft. after _____ hours pumping _____ gpm
 Est. Yield _____ gpm; Well water was _____ ft. after _____ hours pumping _____ gpm
 Bore Hole Diameter: 7 7/8 in. to 52.7 ft., and _____ in. to _____ ft.

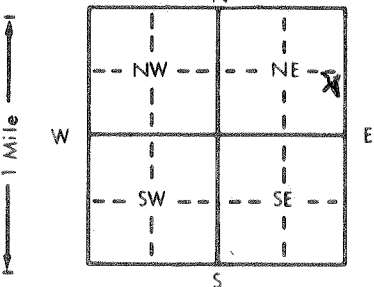

WELL WATER TO BE USED AS:
 5 Public water supply 8 Air conditioning 11 Injection well
 1 Domestic 3 Feedlot 6 Oil field water supply 9 Dewatering 12 Other (Specify below)
 2 Irrigation 4 Industrial 7 Lawn and garden only 10 Monitoring well MW # 3
 Was a chemical/bacteriological sample submitted to Department? Yes X No _____; If yes, mo/day/yr sample was submitted 3-3-88
 Water Well Disinfected? Yes No

5 TYPE OF BLANK CASING USED:
 1 Steel 3 RMP (SR) 5 Wrought iron 8 Concrete tile CASING JOINTS: Glued _____ Clamped _____
2 PVC 4 ABS 6 Asbestos-Cement 9 Other (specify below) Welded
7 Fiberglass Threaded
 Blank casing diameter 2 in. Dia 14.27 ft. Dia _____ in. to _____ ft. Dia _____ in. to _____ ft.
 Casing height above land surface 14 in. weight _____ lbs./ft. Wall thickness or gauge No. Sch 40

TYPE OF SCREEN OR PERFORATION MATERIAL:
 1 Steel 3 Stainless steel 5 Fiberglass 7 PVC 10 Asbestos-cement
 2 Brass 4 Galvanized steel 6 Concrete tile 8 RMP (SR) 11 Other (specify) _____
 9 ABS 12 None used (open hole)

SCREEN OR PERFORATION OPENINGS ARE:
 1 Continuous slot 3 Mill slot 5 Gauzed wrapped 8 Saw cut 11 None (open hole)
 2 Louvered shutter 4 Key punched 6 Wire wrapped 9 Drilled holes
 7 Torch cut 10 Other (specify) _____

SCREEN-PERFORATED INTERVALS: From 27.7 ft. to 37.7 ft., From _____ ft. to _____ ft.
 From 47.7 ft. to 52.7 ft., From _____ ft. to _____ ft.
 GRAVEL PACK INTERVALS: From 26 ft. to 52.7 ft., From _____ ft. to _____ ft.
 From _____ ft. to _____ ft., From _____ ft. to _____ ft.

6 GROUT MATERIAL: 1 Neat cement 2 Cement grout 3 Bentonite 4 Other _____
 Grout Intervals: From 0 ft. to 24 ft., From 24 ft. to 26 ft., From _____ ft. to _____ ft.
 What is the nearest source of possible contamination:
 1 Septic tank 4 Lateral lines 7 Pit privy 10 Livestock pens 14 Abandoned water well
 2 Sewer lines 5 Cess pool 8 Sewage lagoon 11 Fuel storage 15 Oil well/Gas well
 3 Watertight sewer lines 6 Seepage pit 9 Feedyard 12 Fertilizer storage 16 Other (specify below) Machine Shop
 13 Insecticide storage
 Direction from well? North How many feet? 100

FROM	TO	LITHOLOGIC LOG	FROM	TO	PLUGGING INTERVALS
0	4	Dark brown silty clay and top soil	43	50	light brown to grey, fine to med/blk sands, coarse near base (1/2mm) good water zone
4	11	Brown clay, low silt content			
11	17	Grey brown clay, low silt content	50	52.7	Orange brown, fine sand mixed with yellow clay
17	25	light brown silty clay, moderately tight			
25	43	brownish green sandy clay, sand fine to med/blk, subrounded			

7 CONTRACTOR'S OR LANDOWNER'S CERTIFICATION: This water well was (1) constructed, (2) reconstructed, or (3) plugged under my jurisdiction and was completed on (mo/day/year) 10/15/87 and this record is true to the best of my knowledge and belief. Kansas Water Well Contractor's License No. KDHE This Water Well Record was completed on (mo/day/yr) 10/27/88 under the business name of KDHE by (signature) Glen Brown