


1] LOCATION OF WATER WELL: Fraction SW 1/4 SW 1/4 NW 1/4 Section Number 35 Township Number T 6 S S Range Number R 3 EW 10
 County: Cloud
 Distance and direction from nearest town or city street address of well if located within city?
1 mile east 1/2 N of Concordia

2] WATER WELL OWNER: Cloud County Highway Dept.
 RR#, St. Address, Box # :
 City, State, ZIP Code : Concordia, Kansas
 Board of Agriculture, Division of Water Resources
 Application Number:

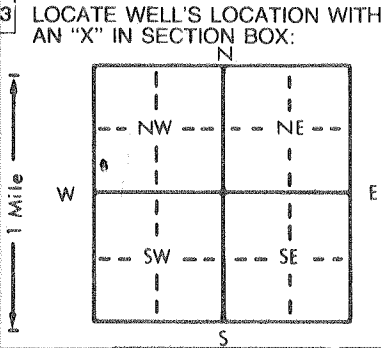

4] DEPTH OF COMPLETED WELL: 60 ft. ELEVATION: ft.
 Depth(s) Groundwater Encountered 1. 22 ft. 2. ft. 3. ft.
 WELL'S STATIC WATER LEVEL 20 ft. below land surface measured on mo/day/yr 4-18-93
 Pump test data: Well water was ft. after hours pumping gpm
 Est. Yield 30 gpm: Well water was ft. after hours pumping gpm
 Bore Hole Diameter: 8 in. to 60 ft., and in. to ft.
 WELL WATER TO BE USED AS:
 5 Public water supply 8 Air conditioning 11 Injection well
 1 Domestic 3 Feedlot 6 Oil field water supply 9 Dewatering 12 Other (Specify below)
 2 Irrigation 4 Industrial 7 Lawn and garden only 10 Monitoring well
 Was a chemical/bacteriological sample submitted to Department? Yes.....No...X...; If yes, mo/day/yr sample was submitted
 Water Well Disinfected? Yes X No

5] TYPE OF BLANK CASING USED:
 1 Steel 3 RMP (SR) 5 Wrought iron 8 Concrete tile CASING JOINTS: Glued X Clamped
2 PVC 4 ABS 6 Asbestos-Cement 9 Other (specify below) Welded
 7 Fiberglass Threaded
 Blank casing diameter 5" in. to 45 ft., Dia in. to ft., Dia in. to ft.
 Casing height above land surface 12" in., weight lbs./ft. Wall thickness or gauge No. 125
 TYPE OF SCREEN OR PERFORATION MATERIAL:
 1 Steel 3 Stainless steel 5 Fiberglass 7 PVC 10 Asbestos-cement
 2 Brass 4 Galvanized steel 6 Concrete tile 8 RMP (SR) 11 Other (specify)
 9 ABS 12 None used (open hole)
 SCREEN OR PERFORATION OPENINGS ARE:
 5 Gauzed wrapped 8 Saw cut 11 None (open hole)
 1 Continuous slot 3 Mill slot 6 Wire wrapped 9 Drilled holes
 2 Louvered shutter 4 Key punched 7 Torch cut 10 Other (specify)
 SCREEN-PERFORATED INTERVALS: From 45' ft. to 60 ft., From ft. to ft.
 From ft. to ft., From ft. to ft.
 GRAVEL PACK INTERVALS: From 20 ft. to 60 ft., From ft. to ft.
 From ft. to ft., From ft. to ft.

6] GROUT MATERIAL: 1 Neat cement 2 Cement grout 3 Bentonite 4 Other
 Grout Intervals: From 0 ft. to 20 ft., From ft. to ft., From ft. to ft.
 What is the nearest source of possible contamination:
 1 Septic tank 4 Lateral lines 7 Pit privy 10 Livestock pens 14 Abandoned water well
 2 Sewer lines 5 Cess pool 8 Sewage lagoon 11 Fuel storage 15 Oil well/Gas well
 3 Watertight sewer lines 6 Seepage pit 9 Feedyard 12 Fertilizer storage 16 Other (specify below)
 13 Insecticide storage N/A
 Direction from well? How many feet?

FROM	TO	LITHOLOGIC LOG	FROM	TO	PLUGGING INTERVALS
<u>0</u>	<u>3</u>	<u>clay</u>			
<u>3</u>	<u>18</u>	<u>sand + clay</u>			
<u>18</u>	<u>60</u>	<u>sand + gravel</u>			
<u>60</u>		<u>stopped</u>			

7] CONTRACTOR'S OR LANDOWNER'S CERTIFICATION: This water well was (1) constructed, (2) reconstructed, or (3) plugged under my jurisdiction and was completed on (mo/day/year) 4-18-93 and this record is true to the best of my knowledge and belief. Kansas Water Well Contractor's License No. 361 This Water Well Record was completed on (mo/day/yr) 6-23-93 under the business name of Pox-Beswick INC SERV by (signature) Onie Beswick