


1 LOCATION OF WATER WELL: County: <u>Cloud</u>	Fraction <u>SW</u> 1/4 <u>NW</u> 1/4 <u>SE</u> 1/4	Section Number <u>35</u>	Township Number <u>T 5 S</u>	Range Number <u>R 3</u> W
---	---	-----------------------------	---------------------------------	---

Distance and direction from nearest town or city street address of well if located within city?

Approximately 1/2 mile east of Concordia

2 WATER WELL OWNER: RR#, St. Address, Box # : City, State, ZIP Code :	<u>Concordia, City of</u> <u>City Hall - 135 E. 6th</u> <u>P.O. Box 603</u> <u>Concordia, KS 66901</u>	Board of Agriculture, Division of Water Resources Application Number: <u>39,720</u>
---	---	--

3 LOCATE WELL'S LOCATION WITH AN "X" IN SECTION BOX:	4 DEPTH OF COMPLETED WELL: <u>67</u> ft. ELEVATION: <u>unknown</u>
--	--

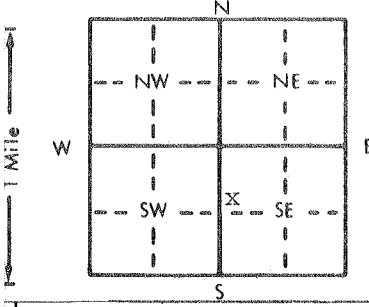

Depth(s) Groundwater Encountered 1. ft. 2. ft. 3. ft.

WELL'S STATIC WATER LEVEL .. 26.9 ... ft. below land surface measured on mo/day/yr

Pump test data: Well water was not ch'd ft. after hours pumping gpm

Est. Yield unknown gpm: Well water was ft. after hours pumping gpm

Bore Hole Diameter .. 36 ... in. to .. 67 ... ft., and .. in. to .. ft.

WELL WATER TO BE USED AS:

5 Public water supply	8 Air conditioning	11 Injection well
1 Domestic	3 Feedlot	6 Oil field water supply
2 Irrigation	4 Industrial	7 Lawn and garden only
		10 Monitoring well
		12 Other (Specify below)

Was a chemical/bacteriological sample submitted to Department? Yes X No; If yes, mo/day/yr sample was submitted Samples submitted previously by City Water Well Disinfected? Yes X No

5 TYPE OF BLANK CASING USED:	5 Wrought iron	8 Concrete tile	CASING JOINTS: Glued Clamped
1 Steel	3 RMP (SR)	6 Asbestos-Cement	9 Other (specify below)
2 PVC	4 ABS	7 Fiberglass	Welded .. <u>X</u> ..
			Threaded

Blank casing diameter .. 12 3/4 ... in. to .. 44 ... ft., Dia .. 12 3/4 ... in. to .. 67 ... ft., Dia in. to ft.

Casing height above land surface .. 62 ... in., weight .. 49.56 ... lbs./ft. Wall thickness or gauge No. .. 375 ...

TYPE OF SCREEN OR PERFORATION MATERIAL:	7 PVC	10 Asbestos-cement
1 Steel	3 Stainless steel	8 RMP (SR)
2 Brass	4 Galvanized steel	9 ABS
5 Fiberglass	6 Concrete tile	11 Other (specify)
		12 None used (open hole)

SCREEN OR PERFORATION OPENINGS ARE:	5 Gauzed wrapped	8 Saw cut	11 None (open hole)
1 Continuous slot	3 Mill slot	6 Wire wrapped	9 Drilled holes
2 Louvered shutter	4 Key punched	7 Torch cut	10 Other (specify)

SCREEN-PERFORATED INTERVALS: From .. 44 ... ft. to .. 64 ... ft., From ft. to ft.

GRAVEL PACK INTERVALS: From .. 38 ... ft. to .. 67 ... ft., From ft. to ft.

6 GROUT MATERIAL:	1 Neat cement	2 <u>Cement grout</u>	3 Bentonite	4 Other <u>Road sand and Bentonite Holeplu</u>
-------------------	---------------	-----------------------	-------------	--

Grout Intervals: From .. 0 ... ft. to .. 20 ... ft., From ft. to ft., From .. 20 ... ft. to .. 38 mixed ... ft.

What is the nearest source of possible contamination:

1 Septic tank	4 Lateral lines	7 Pit privy	10 Livestock pens	14 Abandoned water well
2 Sewer lines	5 Cess pool	8 Sewage lagoon	11 Fuel storage	15 Oil well/Gas well
3 Watertight sewer lines	6 Seepage pit	9 Feedyard	12 Fertilizer storage	16 Other (specify below)
			13 Insecticide storage	<u>Creek</u>

Direction from well? east How many feet? 100

FROM	TO	LITHOLOGIC LOG	FROM	TO	PLUGGING INTERVALS
0	38	Topsoil and clay, brown, soft			
38	39.5	Sand, very fine			
39.5	63	Sand and Gravel, fine to medium to coarse, some fine sand, loose, clean, thin yellow clay streak at 60.5'			
63	67	Clay, brown with some gravel and cobbles mixed			

7 CONTRACTOR'S OR LANDOWNER'S CERTIFICATION: This water well was (1) constructed, (2) reconstructed, or (3) plugged under my jurisdiction and was completed on (mo/day/year) .. 8-28-90 ... and this record is true to the best of my knowledge and belief. Kansas Water Well Contractor's License No. 185 ... This Water Well Record was completed on (mo/day/yr) .. 10-11-90 ... under the business name of Clarke Well & Equipment, Inc. by (signature) Clarke W. Clarke