


USE TYPEWRITER OR BALL POINT PEN-PRESS FIRMLY, PRINT CLEARLY.

WATER WELL RECORD  
KSA 82a-1201-1215

Kansas Department of Health and Environment-Division of Environment  
(Water well Contractors)  
Topeka, Kansas 66620

1. Location of well: County DeCATUR Fraction SE 1/4 NE 1/4 SW 1/4 Section number 24 Township number T 5 S R 30 E 0

2. Distance and direction from nearest town or city: 4 1/2 W - 3 N  
Street address of well location if in city: From Selden  
3. Owner of well: Lawrence Wehler  
R.R. or street:  
City, state, zip code: Selden K.

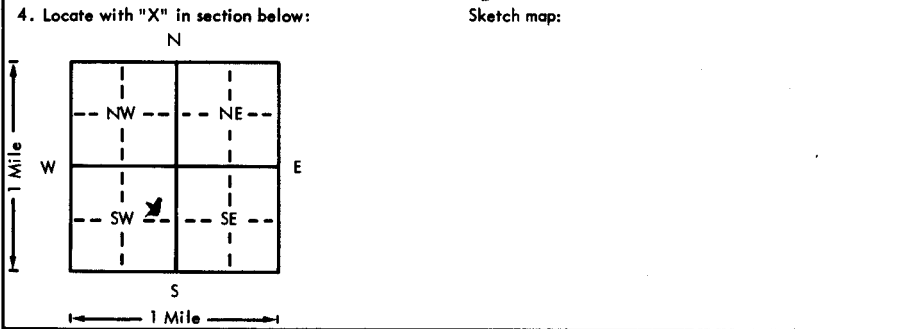

6. Bore hole dia. 20 in. Completion date 12-2-76  
Well depth 193 ft.  
7.  Cable tool  Rotary  Driven  Dug  
 Hollow rod  Jetted  Bored  Reverse rotary  
8. Use:  Domestic  Public supply  Industry  
 Irrigation  Air conditioning  Stock  
 Lawn  Oil field water  Other  
9. Casing: Material Steel Height: Above or below  
Threaded  Welded  Surface 12 in.  
RMP  PVC  Weight  lbs./ft.  
Dia. 12 3/4 to 193 ft. depth Wall Thickness: inches or  
Dia.  in. to  ft. depth gage No. 188

5. Type and color of material:	From	To
<u>Top Soil</u>	<u>0</u>	<u>99</u>
<u>Clay Sand Stone</u>	<u>99</u>	<u>105</u>
<u>Sand &amp; gravel</u>	<u>105</u>	<u>115</u>
<u>Sand Stone</u>	<u>115</u>	<u>125</u>
<u>Sandy clay</u>	<u>125</u>	<u>135</u>
<u>Thin sand medium fine blue</u>	<u>135</u>	<u>185</u>
<u>Sandy clay</u>	<u>185</u>	<u>190</u>
<u>Ocher Shale</u>	<u>190</u>	<u>193</u>

10. Screen: Manufacturer's name W A Brown  
Type Heavy Dia. 12 3/4  
Slot/gauze 7 21 Length 40  
Set between 150 ft. and 190 ft.  
Gravel pack?  Size range of material 4x8 3/4  
11. Static water level: 102 ft. below land surface Date \_\_\_\_\_ mo./day/yr.  
12. Pumping level below land surfaces:  
193 ft. after 5 hrs. pumping 550 g.p.m.  
Estimated maximum yield 550 g.p.m.  
13. Water sample submitted: \_\_\_\_\_ mo./day/yr.  
Yes  No  Date \_\_\_\_\_  
14. Well head completion:  
 Pitless adapter 12 inches above grade  
15. Well grouted? 4 1/2  
With:  Neat cement  Bentonite  Concrete  
Depth: From 0 ft. to 10 ft.  
16. Nearest source of possible contamination:  
ft. \_\_\_\_\_ Direction \_\_\_\_\_ Type NONE  
Well disinfected upon completion?  Yes  No  
17. Pump:  Not installed  
Manufacturer's name \_\_\_\_\_  
Model number \_\_\_\_\_ HP \_\_\_\_\_ Volts \_\_\_\_\_  
Length of drop pipe \_\_\_\_\_ ft. capacity \_\_\_\_\_ g.p.m.  
Type:  
 Submersible  Turbine  
 Jet  Reciprocating  
 Centrifugal  Other

18. Elevation: \_\_\_\_\_  
19. Remarks: \_\_\_\_\_  
Topography:  
 Hill  
 Slope  
 Upland  
 Valley

20. Water well contractor's certification:  
This well was drilled under my jurisdiction and this report is true to the best of my knowledge and belief.  
Blue Jay Drilling Inc 214  
Business name License No. \_\_\_\_\_  
Address Box 503 Colby Ke  
Signed Monty Rall Date 6-3-77  
Authorized representative

T-5  
R-30  
E-2  
S-2  
W-2  
SE 1/4 SW 1/4