

USE TYPEWRITER OR BALL POINT PEN-PRESS FIRMLY, PRINT CLEARLY.

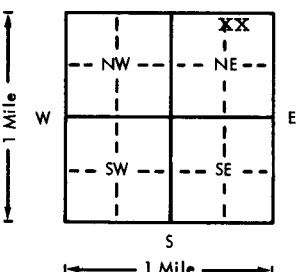
WATER WELL RECORD
KSA 82a-1201-1215

30181

Kansas Department of Health and Environment-Division of Environment
(Water well Contractors)
Topeka, Kansas 66620

TWP: Cook

AAB

<input checked="" type="checkbox"/>	1. Location of well:	County Decatur	Fraction NE 1/4 NE 1/4 NE 1/4	Section number 35	Township number T 5 S R 30	Range number X/W
2. Distance and direction from nearest town or city: 3 miles West & 3 miles North; 1/4 West Street address of well location if in city:			3. Owner of well: Mumm Brothers R.R. or street: Seldon, Kansas City, state, zip code:			
4. Locate with "X" in section below: N  W E S 1 Mile			Sketch map:			6. Bore hole dia. 30 in. Completion date 4-14-76 Well depth 190 ft.
5. Type and color of material			From		To	
			Clay		0	65
Coarse sand & gravel		65	89	7. Cable tool <input type="checkbox"/> Rotary <input type="checkbox"/> Driven <input type="checkbox"/> Dug <input type="checkbox"/> Hollow rod <input type="checkbox"/> Jetted <input type="checkbox"/> Bored <input checked="" type="checkbox"/> Reverse rotary		
Clay		89	94	8. Use: <input type="checkbox"/> Domestic <input type="checkbox"/> Public supply <input type="checkbox"/> Industry <input checked="" type="checkbox"/> Irrigation <input type="checkbox"/> Air conditioning <input type="checkbox"/> Stock <input type="checkbox"/> Lawn <input type="checkbox"/> Oil field water <input type="checkbox"/> Other		
Sandstone		94	95	9. Casing: Material Steel Height: Above or below Threaded <input type="checkbox"/> Welded <input checked="" type="checkbox"/> Surface 12 in. RMP <input type="checkbox"/> PVC <input type="checkbox"/> Weight 7 gauge /ft.		
Clay		95	113	Dia. 16 in. to 124 ft. depth; Wall Thickness: inches or Dia. <input type="checkbox"/> in. to <input type="checkbox"/> ft. depth; Gage No. 0.188		
Clay & sand streaks		113	119	10. Screen: Manufacturer's name Brown 0 10' Cook		
Coarse sand & gravel		119	133	Type Perforated Dia. 16" Slot/gauze 10% Length 60'		
Sandy clay		133	148	Set between 124 ft. and 184 ft. 184 ft. and 194 ft.		
Coarse sand & gravel		148	153	Gravel pack? <input checked="" type="checkbox"/> Size range of material 1/2 X 5/8 50%#1		
Sandy clay		153	163	11. Static water level: <input type="checkbox"/> mo./day/yr. 110 ft. below land surface Date 4-17-76		
Medium to coarse sand & small gravel		163	170	12. Pumping level below land surfaces: 160 ft. after 2 hrs. pumping 290 g.p.m. 180 ft. after 2 hrs. pumping 325 g.p.m. Estimated maximum yield 325 g.p.m.		
Clay		170	172	13. Water sample submitted: <input type="checkbox"/> mo./day/yr. Yes <input checked="" type="checkbox"/> No Date		
Coarse sand & gravel		172	178	14. Well head completion: <input type="checkbox"/> Pitless adapter 12 Inches above grade		
Coarse sand & gravel & clay streaks		178	181	15. Well grouted? <input checked="" type="checkbox"/> With: <input type="checkbox"/> Neat cement <input checked="" type="checkbox"/> Bentonite <input checked="" type="checkbox"/> Clay <input type="checkbox"/> Concrete Depth: From 0 ft. to 10 ft.		
Coarse sand & gravel		181	185	16. Nearest source of possible contamination: ft. 1320 Direction NE Type Farm Well disinfected upon completion? <input type="checkbox"/> Yes <input checked="" type="checkbox"/> No		
Coarse sand & gravel & ochre mix		185	192	17. Pump: <input type="checkbox"/> Not installed Manufacturer's name Floway Model number 7644 HP 30 Volts Length of drop pipe 180 ft. capacity 325 g.p.m.		
Ochre & shale		192	200	Type: 5 stage 10" DOL bowl <input type="checkbox"/> Submersible <input checked="" type="checkbox"/> Turbine <input type="checkbox"/> Jet <input type="checkbox"/> Reciprocating <input type="checkbox"/> Centrifugal <input type="checkbox"/> Other		
18. Elevation:		19. Remarks: BROCK 192' (Use a second sheet if needed)		20. Water well contractor's certification: This well was drilled under my jurisdiction and this report is true to the best of my knowledge and belief. Western Well & Pump Inc. 245 Business name PO Box 852 Colby, KS. License No. Address Sally Berry Date 5/11/76 Signed Authorized representative		
Topography: <input type="checkbox"/> Hill <input type="checkbox"/> Slope <input checked="" type="checkbox"/> Upland <input type="checkbox"/> Valley						

1-5 30 W 35 NE NE NE
 T
 R
 Sec
 1/4 1/4 1/4