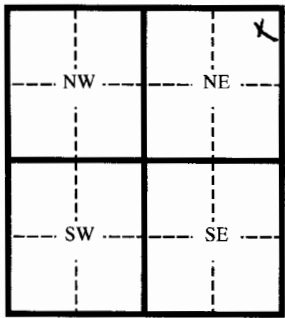


WATER WELL PLUGGING RECORD

FORM WWC-5P

KSA 82a-1212

1 LOCATION OF WATER WELL:	Fraction	Section Number	Township Number	Range Number																																				
County: Decatur	NE 1/4 NE 1/4 NE 1/4	22	5	30																																				
Distance and direction from nearest town or city street address of well if located within city?	
2 WATER WELL OWNER: Gail Mumm	
RR#, St. Address, Box # Box 63	
City, State, ZIP Code : Selden, KS 67757	
Board of Agriculture, Division of Water Resources Application Number: 20070244	
3 MARK WELL'S LOCATION WITH AN "X" IN SECTION BOX:		4 DEPTH OF WELL 155 ft.																																						
		WELL'S STATIC WATER LEVEL 85 ft. WELL WAS USED AS: <table style="width:100%;"> <tr> <td>1 Domestic</td> <td>5 Public Water Supply</td> <td>9 Dewatering</td> </tr> <tr> <td>2 Irrigation</td> <td>☒ 6 Oil Field Water Supply</td> <td>10 Monitoring Well</td> </tr> <tr> <td>3 Feedlot</td> <td>7 Lawn and Garden (domestic)</td> <td>11 Injection Well</td> </tr> <tr> <td>4 Industrial</td> <td>8</td> <td>12 Other</td> </tr> </table>			1 Domestic	5 Public Water Supply	9 Dewatering	2 Irrigation	☒ 6 Oil Field Water Supply	10 Monitoring Well	3 Feedlot	7 Lawn and Garden (domestic)	11 Injection Well	4 Industrial	8	12 Other																								
1 Domestic	5 Public Water Supply	9 Dewatering																																						
2 Irrigation	☒ 6 Oil Field Water Supply	10 Monitoring Well																																						
3 Feedlot	7 Lawn and Garden (domestic)	11 Injection Well																																						
4 Industrial	8	12 Other																																						
Was a chemical/bacteriological sample submitted to Department? Yes _____ No ☒	
If yes, mo/day/yr sample was submitted _____	
Water Well Disinfected: Yes ☒ No _____	
5 TYPE OF BLANK CASING USED:	
<table style="width:100%;"> <tr> <td>1 Steel</td> <td>3 RMP (SR)</td> <td>5 Wrought</td> <td>7 Fiberglass</td> <td>9 Other (specify below)</td> </tr> <tr> <td>☒ 2 PVC</td> <td>4 ABC</td> <td>6 Asbestos-Cement</td> <td>8 Concrete Tile</td> <td></td> </tr> </table>					1 Steel	3 RMP (SR)	5 Wrought	7 Fiberglass	9 Other (specify below)	☒ 2 PVC	4 ABC	6 Asbestos-Cement	8 Concrete Tile																											
1 Steel	3 RMP (SR)	5 Wrought	7 Fiberglass	9 Other (specify below)																																				
☒ 2 PVC	4 ABC	6 Asbestos-Cement	8 Concrete Tile																																					
Blank casing diameter 4.5 in. Was casing pulled? Yes _____ No ☒ If yes, how much _____	
Casing height above or below land surface -36 in.	
6 GROUT PLUG MATERIAL: 1 Neat cement 2 Cement grout <u>3 Bentonite</u> 4 Other _____	
Grout Plug Intervals From 3 ft. to 6 ft. From 82 ft. to 85 ft. From _____ ft. to _____ ft.	
What is the nearest source of possible contamination:	
<table style="width:100%;"> <tr> <td>1 Septic tank</td> <td>6 Seepage pit</td> <td>11 Fuel storage</td> <td>16 Other (specify below)</td> </tr> <tr> <td>2 Sewer lines</td> <td>7 Pit privy</td> <td>12 Fertilizer storage</td> <td></td> </tr> <tr> <td>3 Watertight sewer lines</td> <td>8 Sewage lagoon</td> <td>13 Insecticide storage</td> <td></td> </tr> <tr> <td>4 Lateral lines</td> <td>9 Feedyard</td> <td>14 Abandoned water well</td> <td></td> </tr> <tr> <td>5 Cess Pool</td> <td>10 Livestock pens</td> <td>15 Oil well/ Gas well</td> <td></td> </tr> </table>					1 Septic tank	6 Seepage pit	11 Fuel storage	16 Other (specify below)	2 Sewer lines	7 Pit privy	12 Fertilizer storage		3 Watertight sewer lines	8 Sewage lagoon	13 Insecticide storage		4 Lateral lines	9 Feedyard	14 Abandoned water well		5 Cess Pool	10 Livestock pens	15 Oil well/ Gas well																	
1 Septic tank	6 Seepage pit	11 Fuel storage	16 Other (specify below)																																					
2 Sewer lines	7 Pit privy	12 Fertilizer storage																																						
3 Watertight sewer lines	8 Sewage lagoon	13 Insecticide storage																																						
4 Lateral lines	9 Feedyard	14 Abandoned water well																																						
5 Cess Pool	10 Livestock pens	15 Oil well/ Gas well																																						
Direction from well? _____ How many feet? _____	
<table border="1" style="width:100%; border-collapse: collapse;"> <thead> <tr> <th>FROM</th> <th>TO</th> <th>CODE</th> <th>PLUGGING MATERIALS</th> </tr> </thead> <tbody> <tr> <td>155</td> <td>85</td> <td></td> <td>Chlorinated Sand</td> </tr> <tr> <td>85</td> <td>82</td> <td></td> <td>Bentonite</td> </tr> <tr> <td>82</td> <td>6</td> <td></td> <td>Clay</td> </tr> <tr> <td>6</td> <td>3</td> <td></td> <td>Bentonite</td> </tr> <tr> <td>3</td> <td>0</td> <td></td> <td>Native soil</td> </tr> <tr><td> </td><td> </td><td> </td><td> </td></tr> <tr><td> </td><td> </td><td> </td><td> </td></tr> <tr><td> </td><td> </td><td> </td><td> </td></tr> </tbody> </table>					FROM	TO	CODE	PLUGGING MATERIALS	155	85		Chlorinated Sand	85	82		Bentonite	82	6		Clay	6	3		Bentonite	3	0		Native soil												
FROM	TO	CODE	PLUGGING MATERIALS																																					
155	85		Chlorinated Sand																																					
85	82		Bentonite																																					
82	6		Clay																																					
6	3		Bentonite																																					
3	0		Native soil																																					
7 CONTRACTOR'S OR LANDOWNER'S CERTIFICATION: This water well was plugged under my jurisdiction and was completed on (mo/day/yr) 2/06/08 and this record is true to the best of my knowledge and belief. Kansas Water Well Contractor's License No. 554783 This Water Well Record was completed on (mo/day/yr) 9/01/09 under the business name of Woofert Pump & Well Inc. by (signature) <i>[Signature]</i>	
INSTRUCTIONS: Please fill in blanks and circle the correct answers. Send three copies to Kansas Department of Health and Environment, Bureau of Water, Topeka, Kansas 66620-0001. Telephone: 785-296-3565. Send one to Water Well Owner and retain one for your records.	