


WATER WELL RECORD Form WWC-5 KSA 82a-1212

1 LOCATION OF WATER WELL: County: KAWCINS Fraction: NW 1/4 SE 1/4 SW 1/4 Section Number: 81 Township Number: T 5 S Range Number: R 31 EW

Distance and direction from nearest town or city street address of well if located within city?  
CONFIRMED BY GMD 4

2 WATER WELL OWNER: DANNY BACON  
RR#, St. Address, Box #: Box 353 Board of Agriculture, Division of Water Resources  
City, State, ZIP Code: Hoxie KS 67740 Application Number:

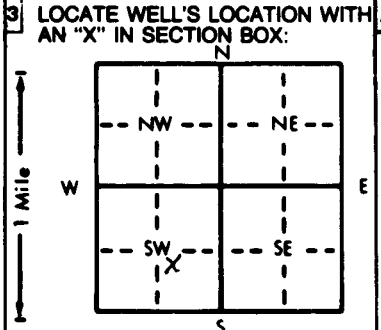

4 DEPTH OF COMPLETED WELL: ~30 ft. ELEVATION:  
Depth(s) Groundwater Encountered 1. .... ft. 2. .... ft. 3. .... ft.  
WELL'S STATIC WATER LEVEL DRY .... ft. below land surface measured on mo/day/yr  
Pump test data: Well water was .... ft. after .... hours pumping .... gpm  
Est. Yield .... gpm; Well water was .... ft. after .... hours pumping .... gpm  
Bore Hole Diameter .... in. to .... ft., and .... in. to .... ft.  
WELL WATER TO BE USED AS: 5 Public water supply 8 Air conditioning 11 Injection well  
① Domestic 3 Feedlot 6 Oil field water supply 9 Dewatering 12 Other (Specify below)  
2 Irrigation 4 Industrial 7 Lawn and garden only 10 Monitoring well  
Was a chemical/bacteriological sample submitted to Department? Yes.....No.....; If yes, mo/day/yr sample was submitted  
Water Well Disinfected? Yes No

5 TYPE OF BLANK CASING USED: 5 Wrought iron 8 Concrete tile CASING JOINTS: Glued ..... Clamped .....  
1 Steel 3 RMP (SR) 6 Asbestos-Cement ⑨ Other (specify below) Welded .....  
2 PVC 4 ABS 7 Fiberglass ROCK LINED Threaded.....  
Blank casing diameter 60 in. to .... ft., Dia. .... in. to .... ft., Dia. .... in. to .... ft.  
Casing height above land surface .... in., weight .... lbs./ft. Wall thickness or gauge No. ....  
TYPE OF SCREEN OR PERFORATION MATERIAL: 7 PVC 10 Asbestos-cement  
1 Steel 3 Stainless steel 5 Fiberglass 8 RMP (SR) 11 Other (specify) .....  
2 Brass 4 Galvanized steel 6 Concrete tile 9 ABS 12 None used (open hole)  
SCREEN OR PERFORATION OPENINGS ARE: 5 Gauzed wrapped 8 Saw cut 11 None (open hole)  
1 Continuous slot 3 Mill slot 6 Wire wrapped 9 Drilled holes  
2 Louvered shutter 4 Key punched 7 Torch cut 10 Other (specify) .....  
SCREEN-PERFORATED INTERVALS: From .... ft. to .... ft., From .... ft. to .... ft.  
GRAVEL PACK INTERVALS: From .... ft. to .... ft., From .... ft. to .... ft.

6 GROUT MATERIAL: 1 Neat cement 2 Cement grout 3 Bentonite ④ Other Clay fill  
Grout intervals: From .... ft. to .... ft., From .... ft. to .... ft., From .... ft. to .... ft.  
What is the nearest source of possible contamination:  
1 Septic tank 4 Lateral lines 7 Pit privy 10 Livestock pens 14 Abandoned water well  
2 Sewer lines 5 Cess pool 8 Sewage lagoon 11 Fuel storage 15 Oil well/Gas well  
3 Watertight sewer lines 6 Seepage pit 9 Feedyard 12 Fertilizer storage 16 Other (specify below)  
13 Insecticide storage  
Direction from well? How many feet?

FROM	TO	LITHOLOGIC LOG	FROM	TO	PLUGGING INTERVALS
					<u>HAND-DUG WELL</u>
					<b>RECEIVED</b>
					<u>OCT 06 1989</u>
					<b>DIVISION OF ENVIRONMENT</b>

7 CONTRACTOR'S OR LANDOWNER'S CERTIFICATION: This water well was (1) constructed, (2) reconstructed, or (3) plugged under my jurisdiction and was completed on (mo/day/year) July 25, 1989 and this record is true to the best of my knowledge and belief. Kansas Water Well Contractor's License No. .... This Water Well Record was completed on (mo/day/year) Sept. 1, 1989 under the business name of ..... by (signature) Danny Bacon

OFFICE USE ONLY  
T  
R  
EW  
SEC.  
1/4  
1/4  
1/4