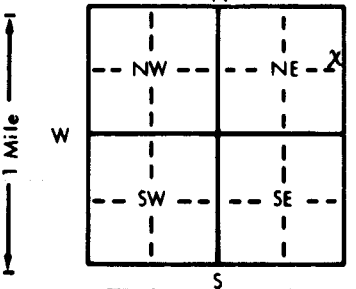


1 LOCATION OF WATER WELL: County: <u>RAWLINS</u> Fraction: <u>SE 1/4 NE 1/4 NE 1/4</u> Section Number: <u>27</u> Township Number: <u>T 5 S</u> Range Number: <u>R 31 EW</u>					
Distance and direction from nearest town or city street address of well if located within city? <u>8 1/2 N 2 W OF REXFORD</u>					
2 WATER WELL OWNER: <u>M. JAY & GUY GIBSON TRUST</u> RR#, St. Address, Box #: <u>C/O LEWIS & LEWIS P.O. BOX 449</u> Board of Agriculture, Division of Water Resources City, State, ZIP Code: <u>ATWOOD, KS 67730</u> Application Number:					
3 LOCATE WELL'S LOCATION WITH AN "X" IN SECTION BOX: 	4 DEPTH OF COMPLETED WELL <u>X</u> <u>120</u> ft. ELEVATION: Depth(s) Groundwater Encountered 1. ft. 2. ft. 3. ft. WELL'S STATIC WATER LEVEL <u>X</u> <u>118</u> ft. below land surface measured on mo/day/yr Pump test data: Well water was ft. after hours pumping gpm Est. Yield gpm: Well water was ft. after hours pumping gpm Bore Hole Diameter in. to ft., and in. to ft. WELL WATER TO BE USED AS: ☒ Domestic ☐ Feedlot ☐ Oil field water supply ☐ Dewatering ☐ 11 Injection well ☐ 12 Other (Specify below) ☐ 2 Irrigation ☐ 4 Industrial ☐ 7 Lawn and garden only ☐ 10 Monitoring well Was a chemical/bacteriological sample submitted to Department? Yes.....No.....; If yes, mo/day/yr sample was sub- mitted Water Well Disinfected? Yes No				
5 TYPE OF BLANK CASING USED: ☒ Steel ☐ 3 RMP (SR) ☐ 5 Wrought iron ☐ 8 Concrete tile CASING JOINTS: Glued Clamped ☐ 2 PVC ☐ 4 ABS ☐ 6 Asbestos-Cement ☐ 9 Other (specify below) Welded Blank casing diameter <u>5</u> in. to ft., Dia in. to ft., Dia in. to ft. Casing height above land surface in., weight lbs./ft. Wall thickness or gauge No. TYPE OF SCREEN OR PERFORATION MATERIAL: ☐ 1 Steel ☐ 3 Stainless steel ☐ 5 Fiberglass ☐ 7 PVC ☐ 10 Asbestos-cement ☐ 2 Brass ☐ 4 Galvanized steel ☐ 6 Concrete tile ☐ 8 RMP (SR) ☐ 11 Other (specify) SCREEN OR PERFORATION OPENINGS ARE: ☐ 1 Continuous slot ☐ 3 Mill slot ☐ 5 Gauzed wrapped ☐ 8 Saw cut ☐ 11 None (open hole) ☐ 2 Louvered shutter ☐ 4 Key punched ☐ 6 Wire wrapped ☐ 9 Drilled holes SCREEN-PERFORATED INTERVALS: From ft. to ft., From ft. to ft. GRAVEL PACK INTERVALS: From ft. to ft., From ft. to ft.					
6 GROUT MATERIAL: ☒ 1 Neat cement ☐ 2 Cement grout ☐ 3 Bentonite ☐ 4 Other Grout Intervals: From <u>10</u> ft. to <u>6</u> ft., From ft. to ft., From ft. to ft. What is the nearest source of possible contamination: ☐ 1 Septic tank ☐ 4 Lateral lines ☐ 7 Pit privy ☐ 10 Livestock pens ☐ 14 Abandoned water well ☐ 2 Sewer lines ☐ 5 Cess pool ☐ 8 Sewage lagoon ☐ 11 Fuel storage ☐ 15 Oil well/Gas well ☐ 3 Watertight sewer lines ☐ 6 Seepage pit ☐ 9 Feedyard ☐ 12 Fertilizer storage ☒ 16 Other (specify below) <u>NONE</u> Direction from well? How many feet?					
FROM	TO	LITHOLOGIC LOG	FROM	TO	PLUGGING INTERVALS
			<u>120</u>	<u>X</u>	<u>DESCRIBE PLUGGING</u>
			<u>115</u>	<u>115</u>	<u>Gravel</u>
			<u>10</u>	<u>10</u>	<u>clay</u>
			<u>5</u>	<u>5</u>	<u>Cement</u>
			<u>5</u>	<u>0</u>	<u>soil</u>
7 CONTRACTOR'S OR LANDOWNER'S CERTIFICATION: This water well was (1) constructed, (2) reconstructed, or ☒ (3) plugged under my jurisdiction and was completed on (mo/day/year) <u>X October, 15, 1988</u> and this record is true to the best of my knowledge and belief. Kansas Water Well Contractor's License No. This Water Well Record was completed on (mo/day/yr) <u>X 3-8-89</u> under the business name of by (signature) <u>x Clyde J. Tennant</u>					

INSTRUCTIONS: Use typewriter or ball point pen. PLEASE PRESS FIRMLY and PRINT clearly. Please fill in blanks, underline or circle the correct answers. Send top three copies to Kansas Department of Health and Environment, Bureau of Water Protection, Topeka, Kansas 66620-7320. Telephone: 913-296-5514. Send one to WATER WELL OWNER and retain one for your records.