

USE TYPEWRITER OR BALL POINT PEN-PRESS FIRMLY, PRINT CLEARLY.


WATER WELL RECORD
KSA 82a-1201-1215

DCC

Kansas Department of Health and Environment-Division of Environment (Water well Contractors) Topeka, Kansas 66620


2. Distance and direction from nearest town or city: 21 miles South & East of Atwood
3. Owner of well: Joe Mentlic
R.R. street
City, state, zip code: Colby

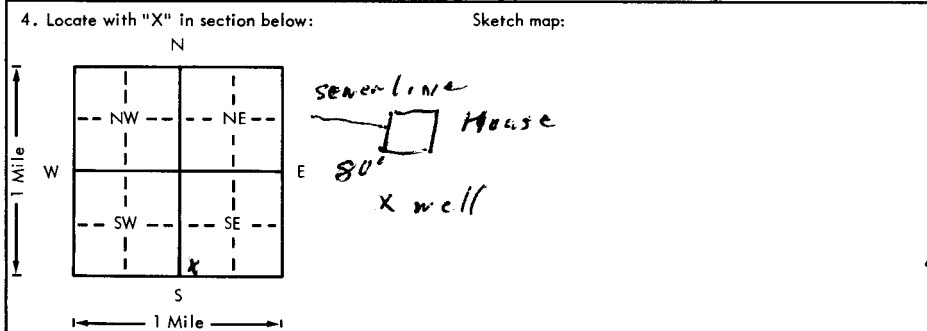

6. Bore hole dia. 8 in. Completion date 8/27
Well depth 210 ft. Drilled
7. Cable tool Rotary Driven Dug
 Hollow rod Jetted Bored Reverse rotary
8. Use: Domestic Public supply Industry
 Irrigation Air conditioning Stock
 Lawn Oil field water Other
9. Casing: Material PVC Height: Above or below
Threaded Welded Surface 24 in.
RMP PVC Weight 30 lbs./ft.
Dia. 5 in. to 202 ft. depth Wall Thickness: inches or
Dia. 5 in. to 202 ft. depth Gage No. 320

5. Type and color of material	From	To
<u>Top soil</u>	<u>0</u>	<u>3</u>
<u>CLAY</u>	<u>3</u>	<u>160</u>
<u>Rock & SAND</u>	<u>160</u>	<u>185</u>
<u>Gravel</u>	<u>185</u>	<u>198</u>
<u>Shale</u>	<u>198</u>	<u>200</u>
<u>BROCK</u>	<u>198</u>	<u>198</u>

10. Screen: Manufacturer's name PVC 1120
Sch 40 ASTM
Type PVC Dia. 5
Slot 1/16 Length 10
Set between 180 ft. and 200 ft.
ft. and 200 ft.
Gravel pack? Size range of material 3/4 1/2
11. Static water level: 110 ft. below land surface Date 8/27 mp./day/yr.
12. Pumping level below land surfaces:
15. Well grouted? YES
With: Neat cement Bentonite Concrete
Depth: From 5 ft. to 15 ft.
16. Nearest source of possible contamination:
ft. 80 Direction NW Type S LIME
Well disinfected upon completion? Yes No
17. Pump: Not installed
Manufacturer's name _____
Model number _____ HP _____ Volts _____
Length of drop pipe _____ ft. capacity _____ g.p.m.
Type:
 Submersible Turbine
 Jet Reciprocating
 Centrifugal Other

18. Elevation: _____
19. Remarks: _____
20. Water well contractor's certification:
This well was drilled under my jurisdiction and this report is true to the best of my knowledge and belief.
Business name HA Drilling License No. 351
Address 802 Atwood
Signed Henry A. Banerjee Date 1/22
authorized representative

T 32 W 20 SW SE USE 1/4 1/4 1/4