

USE TYPEWRITER OR BALL POINT PEN—PRESS FIRMLY, PRINT CLEARLY.

T R EW sec 1/4 1/4 1/4 No.


WATER WELL RECORD
KSA 82a-1201-1215

NCC DDC

Kansas State Dept. Of Health
(Water Well Contractors)
Forbes-Bldg. 740
Topeka, Kansas 66620

1 Location of well: County Rawlins Township name SW 1/4 SE 1/4 Fraction SW 1/4 SE 1/4 Section number 20 Town number 5 Range number 38

Distance and direction from nearest town or city: _____ 3 Owner of well: Joe Mentlik
Street address of well location if in city: _____ Address: Atwood, Ks 67730

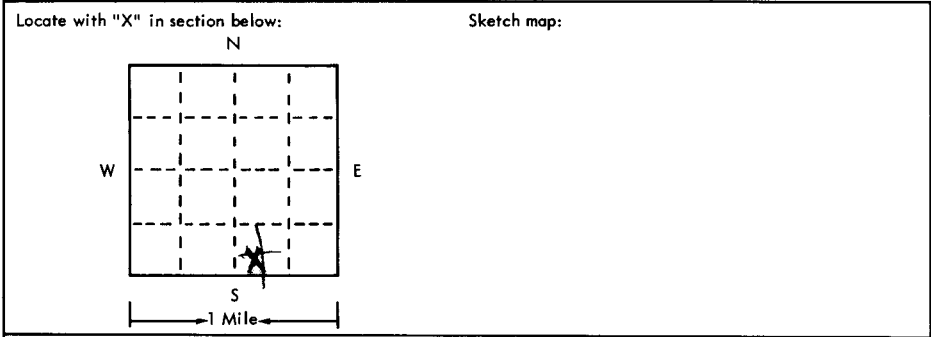

4 Well depth: 197 ft. Date of completion Aug 75
Well diameter 16 in.

5 Cable tool Rotary Driven Dug
 Hollow rod Jetted Bored Reverse rotary

6 Use: Domestic Public supply Industry
 Irrigation Air conditioning Commercial
 Test well

7 Casing: Material Steel Height: above/below
Threaded Welded Surface 12 in.
Digm. 16 in. to 197 ft. depth Weight 32 lbs./ft. 1
Drive shoe? Yes No

2	Type and color of material	From	To
	<u>top soil & clay</u>		<u>130</u>
	<u>3' gorous rock, little clay 7' loose gorous rock</u>	<u>130</u>	<u>140</u>
	<u>8' gorous rock 2' rock</u>	<u>140</u>	<u>150</u>
	<u>2' gorous rock 8' fine sand</u>	<u>150</u>	<u>160</u>
	<u>8' fine sand 2' fine sand and sandy clay</u>	<u>160</u>	<u>170</u>
	<u>8' fine sand 2' sandy clay</u>	<u>170</u>	<u>180</u>
	<u>2' sandy clay 8' sand and gravel</u>	<u>180</u>	<u>190</u>
	<u>3' gravel 4' shale</u>	<u>190</u>	<u>197</u>

8 Screen: Manufacturer W.A. Brown Enterprises
Type free flow Dia. 16"
Slot/gauze 3/16 Length 40'
Set between 157 ft. and 197 ft.
Fittings: 3/4"
Gravel pack Yes No Size range of material _____

9 Static water level: 157 ft. below land surface Date 8-75

10 Pumping level below land surfaces:
140 ft. after 5 hrs. pumping 600 g.p.m.
_____ ft. after _____ hrs. pumping _____ g.p.m.
Estimated maximum yield 600 g.p.m.

11 Water sample submitted:
 Yes No Date _____

12 Well head completion: 12"
 Pitless adapter Inches above grade

13 Well grouted? Yes No Undrilled
 Neat cement Bentonite clay
Depth: From 0 ft. to 10 ft.

14 Nearest source of possible contamination:
ft. _____ Direction _____ Type _____
Well disinfected upon completion? Yes No

15 Pump: Not installed
Manufacturer's name Western Sand Roller
Model number 106/HC HP _____ Volts _____
Length of drop pipe _____ ft. capacity _____ g.m.p.
Type:
 Submersible Turbine
 Jet Reciprocating
 Centrifugal Other

16 Remarks: elevation
Topography:
 Hill
 Slope
 Upland
 Valley

3071 (TOP)
3067

17 Water well contractor's certification:
This well was drilled under my jurisdiction and this report is true to the best of my knowledge and belief.
Jack Poore drilling 197
Business name _____ License No. _____
Address McDonald Ks
Signed Jack Poore Date 9-5-75
Authorized representative