


1 LOCATION OF WATER WELL: Fraction NW 1/4 NE 1/4 SE Section Number 6 Township Number 5 Range Number 33 EW  
 County: Rawlins

Distance and direction from nearest town or city street address of well if located within city?

2 WATER WELL OWNER: John Rogers  
 RR #, St. Address, Box #: Rt 1 Box 65 Board of Agriculture, Division of Water Resources  
 City, State, ZIP Code: Atwood, KS 67730 Application Number: \_\_\_\_\_

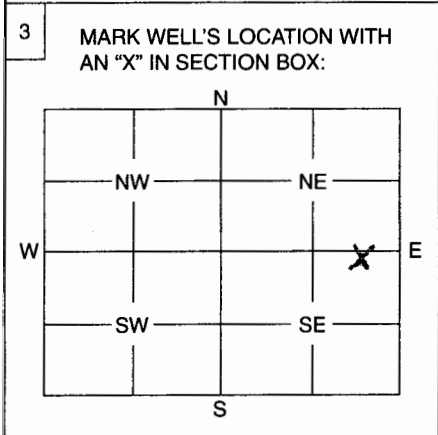

4 DEPTH OF WELL 172 ft.  
 WELL'S STATIC WATER LEVEL 164 ft.  
 WELL WAS USED AS:  
 Domestic      5 Public Water Supply      9 Dewatering  
 2 Irrigation      6 Oil Field Water Supply      10 Monitoring Well  
 3 Feedlot      7 Domestic (Lawn & Garden)      11 Injection Well  
 4 Industrial      8 Air Conditioning      12 Other \_\_\_\_\_  
 Was a chemical / bacteriological sample submitted to Department? Yes \_\_\_\_\_ No   
 If yes, mo/day/yr sample was submitted \_\_\_\_\_  
 Water Well Disinfected: Yes  No \_\_\_\_\_

5 TYPE OF BLANK CASING USED:  
 Steel      3 RMP (SR)      5 Wrought      7 Fiberglass      9 Other (Specify below)  
 2 PVC      4 ABS      6 Asbestos-Cement      8 Concrete Tile  
 Blank casing diameter 5" in.      Was casing pulled? Yes  No \_\_\_\_\_ If yes, how much 9'  
 Casing height above or below land surface 9' in.

6 GROUT PLUG MATERIAL:  Neat cement       Cement grout       Bentonite      4 Other \_\_\_\_\_  
 Grout Plug Intervals: From 155 ft. to 135 ft., From 22 ft. to 5 ft., From \_\_\_\_\_ to \_\_\_\_\_ ft.  
 What is the nearest source of possible contamination:  
 1 Septic tank      6 Seepage pit      11 Fuel storage      16 Other (specify below) Tree Roots from windbreak  
 2 Sewer lines      7 Pit privy      12 Fertilizer storage  
 3 Watertight sewer lines      8 Sewage lagoon      13 Insecticide storage  
 4 Lateral lines      9 Feedyard      14 Abandoned water well  
 5 Cess pool      10 Livestock pens      15 Oil well/Gas well  
 Direction from well? S      How many feet? 6

FROM	TO	PLUGGING MATERIALS
172	155	washed sand
155	135	Bentonite
135	22	Clay
22	5	Bentonite with Cement Grout Cap
5	0	Compacted Clay + Topsoil

**RECEIVED**  
 DEC 21 2009  
**BUREAU OF WATER**

7 CONTRACTOR'S OF LANDOWNER'S CERTIFICATION: This water well was plugged under my jurisdiction and was completed on (mo/day/year) 12-12-09 and this record is true to the best of my knowledge and belief. Kansas Water Well Contractor's License No. 663 This Water Well Record was completed on (mo/day/year) 12-18-09 under the business name of Brenn Pump & Supply by (signature) [Signature]

INSTRUCTIONS: Use typewriter or ball point pen. Please press firmly and print clearly. Please fill in blanks, underline or circle the correct answers. Send top three copies to Kansas Department of Health and Environment, Bureau of Water, Geology Section, 1000 SW Jackson St., Ste. 420, Topeka, Kansas 66612-1367. Telephone: 785/296-5522. Send one to Water Well Owner and retain one for your records.