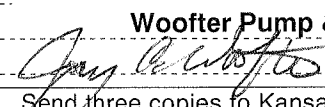


## WATER WELL PLUGGING RECORD

FORM WWC-5P

KSA 82a-1212

1 LOCATION OF WATER WELL:	Fraction	Section Number	Township Number	Range Number						
County: <b>Rawlins</b>	<b>NW 1/4 SE 1/4 NW 1/4</b>	<b>9</b>	<b>5s</b>	<b>33w</b>						
Distance and direction from nearest town or city street address of well if located within city? <b>17 miles north—1 east—1 south of Colby</b>										
2 WATER WELL OWNER: <b>Robert Ruda</b>										
RR#, St. Address, Box # <b>303 N 2<sup>nd</sup></b>		Board of Agriculture, Division of Water Resources								
City, State, ZIP Code : <b>Atwood, KS 67730</b>		Application Number: <b>20110585</b>								
3 MARK WELL'S LOCATON WITH AN "X" IN SECTION BOX:		4 DEPTH OF WELL <b>200</b> ft.								
<div style="text-align: center;">N</div> <table border="1" style="margin: auto; border-collapse: collapse;"> <tr> <td style="width: 50px; height: 50px; text-align: center;">NW</td> <td style="width: 50px; height: 50px; text-align: center;">NE</td> </tr> <tr> <td style="text-align: center;">X</td> <td></td> </tr> <tr> <td style="width: 50px; height: 50px; text-align: center;">SW</td> <td style="width: 50px; height: 50px; text-align: center;">SE</td> </tr> </table> <div style="text-align: center;">S</div> <div style="display: flex; justify-content: space-between; width: 100%;"> <span>W</span> <span>E</span> </div>		NW	NE	X		SW	SE	WELL'S STATIC WATER LEVEL <b>120</b> ft.		
		NW	NE							
X										
SW	SE									
WELL WAS USED AS:										
		<div style="display: flex; justify-content: space-between;"> <div> 1 Domestic 2 Irrigation 3 Feedlot 4 Industrial </div> <div> 5 Public Water Supply <input checked="" type="checkbox"/> 6 Oil Field Water Supply 7 Lawn and Garden (domestic) 8 </div> <div> 9 Dewatering 10 Monitoring Well 11 Injection Well 12 Other </div> </div>								
		Was a chemical/bacteriological sample submitted to Department? Yes ___ No <b>X</b> If yes, mo/day/yr sample was submitted _____ Water Well Disinfected: Yes <b>X</b> No ___								
5 TYPE OF BLANK CASING USED:										
1 Steel      3 RMP (SR)      5 Wrought      7 Fiberglass      9 Other (specify below) <input checked="" type="checkbox"/> 2 PVC      4 ABC      6 Asbestos-Cement      8 Concrete Tile										
Blank casing diameter <b>4.5</b> in. Was casing pulled? Yes ___ No <b>X</b> If yes, how much _____										
Casing height above or below land surface <b>-36</b> in.										
6 GROUT PLUG MATERIAL: 1 Neat cement    2 Cement grout <u>3 Bentonite</u> 4 Other _____										
Grout Plug Intervals From <b>3</b> ft. to <b>6</b> ft. From <b>117</b> ft. to <b>120</b> ft. From _____ ft. to _____ ft.										
What is the nearest source of possible contamination:										
<div style="display: flex; flex-wrap: wrap;"> <div style="width: 33%;">1 Septic tank</div> <div style="width: 33%;">6 Seepage pit</div> <div style="width: 33%;">11 Fuel storage</div> <div style="width: 33%;">16 Other (specify below)</div> <div style="width: 33%;">2 Sewer lines</div> <div style="width: 33%;">7 Pit privy</div> <div style="width: 33%;">12 Fertilizer storage</div> <div style="width: 33%;"></div> <div style="width: 33%;">3 Watertight sewer lines</div> <div style="width: 33%;">8 Sewage lagoon</div> <div style="width: 33%;">13 Insecticide storage</div> <div style="width: 33%;"></div> <div style="width: 33%;">4 Lateral lines</div> <div style="width: 33%;">9 Feedyard</div> <div style="width: 33%;">14 Abandoned water well</div> <div style="width: 33%;"></div> <div style="width: 33%;">5 Cess Pool</div> <div style="width: 33%;">10 Livestock pens</div> <div style="width: 33%;">15 Oil well/ Gas well</div> <div style="width: 33%;"></div> </div>										
Direction from well? _____		How many feet? _____								
FROM	TO	CODE	PLUGGING MATERIALS							
<b>0</b>	<b>3</b>		<b>Nati ve soil</b>							
<b>3</b>	<b>6</b>		<b>Bentonite</b>							
<b>6</b>	<b>117</b>		<b>Clay</b>							
<b>117</b>	<b>120</b>		<b>Bentonite</b>							
<b>120</b>	<b>200</b>		<b>Chlorinated sand</b>							
7 CONTRACTOR'S OR LANDOWNER'S CERTIFICATION: This water well was plugged under my jurisdiction and was completed on (mo/day/yr) <b>1/10/12</b> and this record is true to the best of my knowledge and belief. Kansas Water Well Contractor's License No. <b>554</b> This Water Well Record was completed on (mo/day/yr) <b>1/11/12</b> under the business name of <b>Woofter Pump &amp; Well Inc.</b> by (signature) 										
INSTRUCTIONS: Please fill in blanks and circle the correct answers. Send three copies to Kansas Department of Health and Environment, Bureau of Water, Topeka, Kansas 66620-0001. Telephone: 785-296-3565. Send one to Water Well Owner and retain one for your records.										