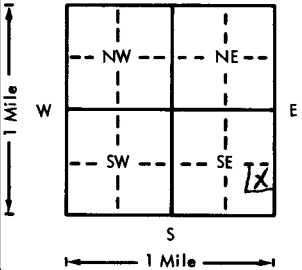


USE TYPEWRITER OR BALL POINT PEN-PRESS FIRMLY, PRINT CLEARLY.

WATER WELL RECORD  
KSA 82a-1201-1215

Kansas Department of Health and Environment-Division of Environment  
(Water well Contractors)  
Topeka, Kansas 66620

*DNA*

1. Location of well:	County <b>RAWLINS</b>	Fraction <b>NE 1/4 SE 1/4 SE 1/4</b>	Section number <b>B</b>	Township number T <b>5</b> S R <b>33</b> <b>NW</b>	Range number
2. Distance and direction from nearest town or city: <b>10 miles South</b> Street address of well location if in city: <b>4 East 1 South of Atwood</b>			3. Owner of well: <b>Reno Cooper</b> R.R. or street: City, state, zip code: <b>Atwood, KAN 67730</b>		
4. Locate with "X" in section below: N W E S 1 Mile Sketch map: 			6. Bore hole dia. <u>  </u> in. Completion date <u>  </u> Well depth <b>95</b> ft. <u>  </u> <b>8/11/76</b>		
5. Type and color of material			7. <input type="checkbox"/> Cable tool <input checked="" type="checkbox"/> Rotary <input type="checkbox"/> Driven <input type="checkbox"/> Dug <input type="checkbox"/> Hollow rod <input type="checkbox"/> Jetted <input type="checkbox"/> Bored <input type="checkbox"/> Reverse rotary		
			8. Use: <input type="checkbox"/> Domestic <input type="checkbox"/> Public supply <input type="checkbox"/> Industry <input type="checkbox"/> Irrigation <input type="checkbox"/> Air conditioning <input checked="" type="checkbox"/> Stock <input type="checkbox"/> Lawn <input type="checkbox"/> Oil field water <input type="checkbox"/> Other		
From To			9. Casing: Material <b>Plts</b> Height: Above or below Threaded <input type="checkbox"/> Welded <b>GL</b> Surface <b>24</b> in. RMP <input type="checkbox"/> PVC <input checked="" type="checkbox"/> Weight <u>  </u> lbs./ft. Dia. <b>5</b> in. to <b>97</b> ft. depth Wall Thickness: inches or Dia. <u>  </u> in. to <u>  </u> ft. depth gage No. <b>932</b>		
			10. Screen: Manufacturer's name <b>Jesse Howell</b> Type <b>PVC</b> Dia. <b>5</b> Slot/gauze <b>3/16</b> Length <b>10</b> Set between <b>85</b> ft. and <b>95</b> ft. <u>  </u> ft. and <u>  </u> ft. Gravel pack? <b>yes</b> Size range of material <b>3/8 &amp; 5/8</b>		
Top soil			11. Static water level: <u>  </u> mo./day/yr. <b>26</b> ft. below land surface Date <b>8/11/76</b>		
Clay Silty 2 Brown			12. Pumping level below land surfaces: <u>  </u> ft. after <u>  </u> hrs. pumping <u>  </u> g.p.m. <u>  </u> ft. after <u>  </u> hrs. pumping <u>  </u> g.p.m. Estimated maximum yield <u>  </u> g.p.m.		
SAND FINE brown			13. Water sample submitted: <u>  </u> mo./day/yr. <input type="checkbox"/> Yes <input checked="" type="checkbox"/> No Date <u>  </u>		
Rock SANDY TAN			14. Well head completion: <input type="checkbox"/> Pitless adapter <u>  </u> inches above grade		
SAND FINE brown			15. Well grouted? <b>yes</b> With: <input checked="" type="checkbox"/> Neat cement <input type="checkbox"/> Bentonite <input type="checkbox"/> Concrete Depth: From <u>  </u> ft. to <u>  </u> ft.		
SAND Med brown			16. Nearest source of possible contamination: ft. <b>100</b> Direction <b>WEST</b> Type <b>RUN OFF</b> Well disinfected upon completion? <input type="checkbox"/> Yes <input type="checkbox"/> No		
SAND Med to coarse brown			17. Pump: <input checked="" type="checkbox"/> Not installed Manufacturer's name <u>  </u> Model number <u>  </u> HP <u>  </u> Volts <u>  </u> Length of drop pipe <u>  </u> ft. capacity <u>  </u> g.p.m. Type: <input type="checkbox"/> Submersible <input type="checkbox"/> Turbine <input type="checkbox"/> Jet <input type="checkbox"/> Reciprocating <input type="checkbox"/> Centrifugal <input type="checkbox"/> Other		
SHALE Compact black			18. Elevation:		
(Use a second sheet if needed)			19. Remarks:		
			20. Water well contractor's certification: This well was drilled under my jurisdiction and this report is true to the best of my knowledge and belief. <b>H. A. Drilling</b> <b>331</b> Business name License No. Address <b>Atwood, KAN</b> Signed <b>Rory A. Beerly</b> Date <b>8/27</b> Authorized representative		

T-5  
 R-33  
 W-2  
 NE SE  
 SE SE  
 SE SE  
 Sec  
 1/4 1/4 1/4