

USE TYPEWRITER OR BALL POINT PEN-PRESS FIRMLY, PRINT CLEARLY.

T R EW sec 1/4 1/4 1/4 No.


WATER WELL RECORD  
KSA 2a-1201-1215

Kansas State Dept. Of Health  
(Water Well Contractors)  
Forbes-Bldg. 740  
Topeka, Kansas 66620

**AAA**

1 Location of well:	County <u>Rawlins</u>	Township name	Fraction <u>SW-NE-NE-NE</u>	Section number <u>6</u>	Town number <u>5 5</u>	Range number <u>33 W</u>
---------------------	--------------------------	---------------	--------------------------------	----------------------------	---------------------------	-----------------------------

Distance and direction from nearest town or city: <u>S. of Atwood Ks. 12 1/2 Miles</u>	3 Owner of well: <u>Duane Roesch</u> <u>Star Route</u> <u>Colby, Kansas 67701</u>
Street address of well location if in city:	Address:

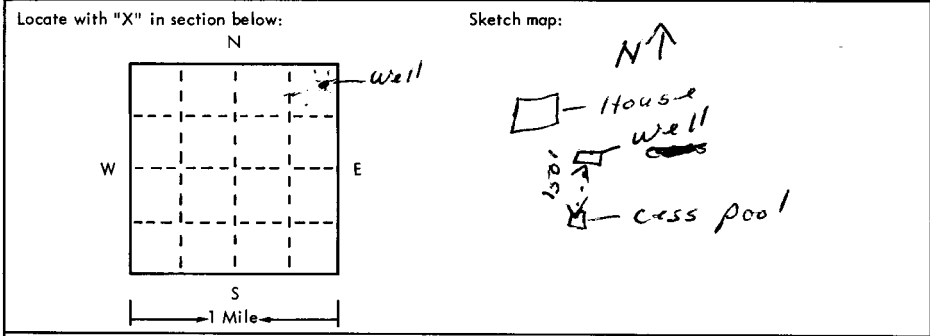

4 Well depth: <u>263</u> ft. Date of completion: <u>8-13-76</u> Well diameter <u>6</u> in.
5 <input type="checkbox"/> Cable tool <input type="checkbox"/> Rotary <input type="checkbox"/> Driven <input type="checkbox"/> Dug <input type="checkbox"/> Hollow rod <input type="checkbox"/> Jetted <input type="checkbox"/> Bored <input checked="" type="checkbox"/> Reverse rotary
6 Use: <input checked="" type="checkbox"/> Domestic <input type="checkbox"/> Public supply <input type="checkbox"/> Industry <input type="checkbox"/> Irrigation <input type="checkbox"/> Air conditioning <input type="checkbox"/> Commercial <input type="checkbox"/> Test well <input type="checkbox"/>
7 Casing: Material <u>PVC</u> Height: above <u>ground</u> Threaded <input type="checkbox"/> Welded <input checked="" type="checkbox"/> Surface <u>12</u> in. Diam. <u>5</u> in. to <u>263</u> ft. depth Drive shoe? <input type="checkbox"/> Yes <input checked="" type="checkbox"/> No <u>5</u> in. to <u>263</u> ft. depth

2	Type and color of material	From	To
	<u>Topsoil, Clay, Silty, Clay, Brown</u>	<u>0</u>	<u>170</u>
	<u>Fine Sand, Med. Gravel Brown</u>	<u>170</u>	<u>174</u>
	<u>Sandy Clay, Streak Sand Stone, Brown</u>	<u>174</u>	<u>192</u>
	<u>Med. Gravel, Streak Sandy Clay, Sand Stone</u>	<u>192</u>	<u>200</u>
	<u>Fine Sand, Med. Gravel, Brown</u>	<u>200</u>	<u>210</u>
	<u>Fine Sand, Med. Gravel, Streak Sandy Clay</u>		
	<u>Streak Sand Stone</u>	<u>210</u>	<u>220</u>
	<u>Fine Sand, Streak Rock, Sand Stone</u>	<u>220</u>	<u>234</u>
	<u>Sandy Clay, Brown</u>	<u>234</u>	<u>250</u>
	<u>Fine Sand, Med. Gravel, Sand Stone</u>	<u>250</u>	<u>259</u>
	<u>Ochre - yellow Shale - blue</u>	<u>259</u>	<u>263</u>
	<u>Rock</u>	<u>263</u>	
	<b>BROCK 259</b>		
	(use a second sheet if needed)		

8 Screen: Manufacturer <u>Neb Plastics</u> Type <u>slot</u> Dia. <u>5"</u> Slot/gauze _____ Length <u>10'</u> Set between <u>253</u> ft. and <u>263</u> ft. Fittings: Gravel pack <input checked="" type="checkbox"/> Yes <input type="checkbox"/> No Size range of material <u>8-14</u>
9 Static water level: <u>174</u> ft. below land surface Date <u>8-10-76</u>
10 Pumping level below land surfaces: <u>240</u> ft. after <u>6</u> hrs. pumping <u>36</u> g.p.m. _____ ft. after _____ hrs. pumping _____ g.p.m. Estimated maximum yield <u>40</u> g.p.m.
11 Water sample submitted: <input type="checkbox"/> Yes <input checked="" type="checkbox"/> No Date _____
12 Well head completion: <u>white water tank</u> <input type="checkbox"/> Pitless adapter <input type="checkbox"/> Inches above grade
13 Well grouted? <input checked="" type="checkbox"/> Yes <input type="checkbox"/> No <input checked="" type="checkbox"/> Neat cement <input type="checkbox"/> Bentonite <input type="checkbox"/> _____ Depth: From <u>0</u> ft. to <u>10</u> ft.
14 Nearest source of possible contamination: ft. <u>150</u> Direction <u>S</u> Type <u>Cess pool</u> Well disinfected upon completion? <input checked="" type="checkbox"/> Yes <input type="checkbox"/> No
15 Pump: <input type="checkbox"/> Not installed Manufacturer's name <u>Gould</u> Model number <u>J0744</u> HP <u>34</u> Volts <u>230</u> Length of drop pipe <u>231</u> ft. capacity <u>50</u> g.m.p. Type: <input checked="" type="checkbox"/> Submersible <input type="checkbox"/> Turbine <input type="checkbox"/> Jet <input type="checkbox"/> Reciprocating <input type="checkbox"/> Centrifugal <input type="checkbox"/> Other

16 Remarks: elevation

Topography:  
 Hill  
 Slope  
 Upland  
 Valley

17 Water well contractor's certification:  
This well was drilled under my jurisdiction and this report is true to the best of my knowledge and belief.  
Red Tiger Inc 125-  
Business name \_\_\_\_\_ License No. \_\_\_\_\_  
Address Box 524 Colby, KS  
Signed Duane Roesch Date 8-13-76  
Authorized representative

5 33W 6 NE 10 1/4