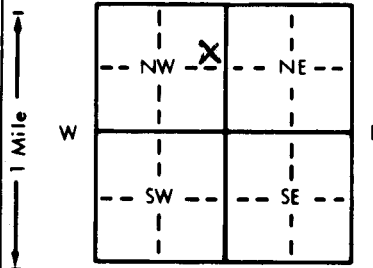


1 LOCATION OF WATER WELL: County: <u>Rawlins</u>	Fraction <u>SE 1/4 NE 1/4 NW 1/4</u>	Section Number <u>19</u>	Township Number T <u>5</u> S	Range Number R <u>34</u> EW
---	---	-----------------------------	---------------------------------	--------------------------------

Distance and direction from nearest town or city street address of well if located within city?

2 WATER WELL OWNER: RR#, St. Address, Box # : <u>Mary E. Maley</u> City, State, ZIP Code : <u>Salina, KS 67401</u>	Board of Agriculture, Division of Water Resources Application Number:
--	--

3 LOCATE WELL'S LOCATION WITH AN "X" IN SECTION BOX: 	4 DEPTH OF COMPLETED WELL: <u>190</u> ft. ELEVATION: Depth(s) Groundwater Encountered 1. <u>170</u> ft. 2. ft. 3. ft. WELL'S STATIC WATER LEVEL ft. below land surface measured on mo/day/yr Pump test data: Well water was ft. after hours pumping gpm Est. Yield gpm: Well water was ft. after hours pumping gpm Bore Hole Diameter in. to ft., and in. to ft. WELL WATER TO BE USED AS: <input checked="" type="checkbox"/> Domestic 3 Feedlot 6 Oil field water supply 9 Dewatering 12 Other (Specify below) 2 Irrigation 4 Industrial 7 Lawn and garden only 10 Monitoring well Was a chemical/bacteriological sample submitted to Department? Yes No; If yes, mo/day/yr sample was submitted
--	---

5 TYPE OF BLANK CASING USED: 1 Steel 3 RMP (SR) 5 Wrought iron 8 Concrete tile 2 PVC 4 ABS 6 Asbestos-Cement 9 Other (specify below) Blank casing diameter in. to <u>190</u> ft. Dia. in. to ft. Dia. in. to ft. Casing height above land surface <u>48 to 60</u> in. weight lbs./ft. Wall thickness or gauge No. TYPE OF SCREEN OR PERFORATION MATERIAL: 1 Steel 3 Stainless steel 5 Fiberglass 7 PVC 10 Asbestos-cement 2 Brass 4 Galvanized steel 6 Concrete tile 8 RMP (SR) 11 Other (specify) 12 None used (open hole) SCREEN OR PERFORATION OPENINGS ARE: 1 Continuous slot 3 Mill slot 5 Gauzed wrapped 8 Saw cut 11 None (open hole) 2 Louvered shutter 4 Key punched 6 Wire wrapped 9 Drilled holes 10 Other (specify) SCREEN-PERFORATED INTERVALS: From ft. to ft., From ft. to ft., From ft. to ft. GRAVEL PACK INTERVALS: From ft. to ft., From ft. to ft., From ft. to ft.
---

6 GROUT MATERIAL: 1 Neat cement 2 Cement grout 3 Bentonite 4 Other Grout Intervals: From ft. to ft., From ft. to ft., From ft. to ft. What is the nearest source of possible contamination: <u>None</u> 1 Septic tank 4 Lateral lines 7 Pit privy 10 Livestock pens 14 Abandoned water well 2 Sewer lines 5 Cess pool 8 Sewage lagoon 11 Fuel storage 15 Oil well/Gas well 3 Watertight sewer lines 6 Seepage pit 9 Feedyard 12 Fertilizer storage 16 Other (specify below) 13 Insecticide storage Direction from well? How many feet?
--

FROM	TO	LITHOLOGIC LOG	FROM	TO	PLUGGING INTERVALS
			190	170	Clean Sand (Chlorine)
			170	15	Clay
			15	5	Cement
					Cut off 5 ft below ground level so it can be farmed over.

7 CONTRACTOR'S OR LANDOWNER'S CERTIFICATION: This water well was (1) constructed, (2) reconstructed, or (3) plugged under my jurisdiction and was completed on (mo/day/year) and this record is true to the best of my knowledge and belief. Kansas Water Well Contractor's License No. This Water Well Record was completed on (mo/day/yr) under the business name of	by (signature) <u>March 14, 89</u> <u>Gordon J. Goudie</u>
--	---