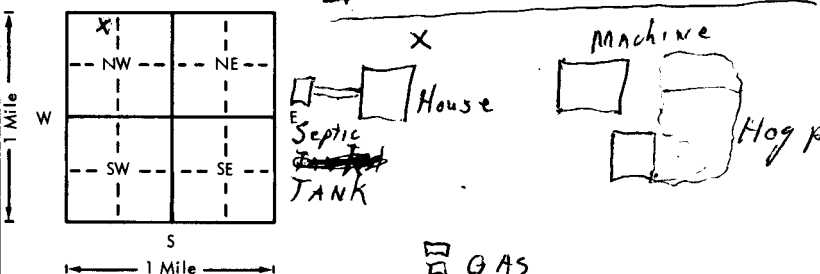


USE TYPEWRITER OR BALL
POINT PEN-PRESS FIRMLY,
PRINT CLEARLY.

WATER WELL RECORD
KSA 82a-1201-1215

Kansas Department of Health and
Environment-Division of Environment
(Water well Contractors)
Topeka, Kansas 66620

1. Location of well:		County <u>RAWLINS</u>	Fraction <u>NE 1/4 NW 1/4 NW 1/4</u>	Section number <u>20</u>	Township number T <u>5</u> S	Range number R <u>34</u> W
2. Distance and direction from nearest town or city: Street address of well location if in city:		13 M South 5 West 1 South <u>34 West of Atwood</u>		3. Owner of well: R.R. or street: City, state, zip code:		
4. Locate with "X" in section below:		Sketch map:		6. Bore hole dia. <u>8</u> in. Completion date Well depth <u>243</u> ft. <u>8/5/76</u>		
				7. Cable tool ☒ Rotary ☐ Driven ☐ Dug ☐ Hollow rod ☐ Jetted ☐ Bored ☐ Reverse rotary		
5. Type and color of material		From		To		8. Use: ☒ Domestic ☐ Public supply ☐ Industry ☐ Irrigation ☐ Air conditioning ☐ Stock ☐ Lawn ☐ Oil field water ☐ Other
Top soil		0		3		9. Casing: Material <u>PLS</u> Height: Above or below Threaded ☐ Welded <u>GL</u> Surface <u>24</u> in. RMP ☐ PVC ☒ Weight ☐ lbs./ft.
CLAY, silty, & brown		3		80		Dia. <u>5</u> in. to <u>243</u> ft. depth Wall Thickness: inches or Dia. <u>5</u> in. to <u>243</u> ft. depth gauge No. <u>243</u>
Rock, slick, white		80		86		10. Screen: Manufacturer's name <u>Jess & Howell</u> Type <u>PVC</u> Dia. <u>5"</u> Slot/gauze <u>20</u> Length <u>20</u> Set between <u>223</u> ft. and <u>243</u> ft. Gravel pack? ☒ Size range of material <u>3/8 to 1/2</u>
CLAY, gummy, gray		86		90		11. Static water level: <u>188</u> ft. below land surface Date <u>8/5/76</u> mo./day/yr.
SAND V F brown		90		100		12. Pumping level below land surfaces: ft. after hrs. pumping g.p.m. ft. after hrs. pumping g.p.m. Estimated maximum yield g.p.m.
SAND River gravel Red & brown		100		140		13. Water sample submitted: <u>Yes</u> ☒ No ☐ Date
SAND Med to Fine Red & brown		140		170		14. Well head completion: ☒ Pitless adapter <u>24</u> inches above grade
Rock SANDY Red & brown		170		175		15. Well grouted? <u>yes</u> With: ☒ Neat cement ☐ Bentonite ☐ Concrete Depth: From <u>15</u> ft. to <u>15</u> ft.
SAND Med. to Fine Red & brown		175		200		16. Nearest source of possible contamination: ft. <u>200</u> Direction <u>EAST</u> Type <u>Hog pens</u> Well disinfected upon completion? ☒ Yes ☐ No
Rock SANDY Red & brown		200		205		17. Pump: ☒ Not installed Manufacturer's name Model number HP Volts Length of drop pipe ft. capacity g.p.m. Type: ☐ Submersible ☐ Turbine ☐ Jet ☐ Reciprocating ☐ Centrifugal ☐ Other
SAND FINE to Med.		205		240		18. Elevation:
CLAY (shale) compact Gray & Yellow		240		243		19. Remarks: <u>Pump & adapter set by</u> <u>RAWLINS County Well Service</u>
BROOK 240						20. Water well contractor's certification: This well was drilled under my jurisdiction and this report is true to the best of my knowledge and belief. <u>HA Drilling</u> 331 Business name License No. Address <u>Atwood, Kan.</u> Signed <u>Rory A. Bandy</u> Date <u>8/27</u> Authorized representative