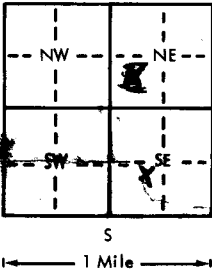
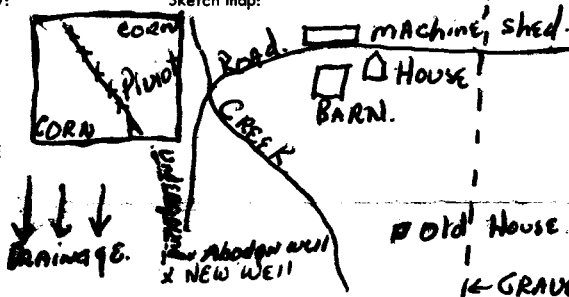


USE TYPEWRITER OR BALL
POINT PEN-PRESS FIRMLY,
PRINT CLEARLY.

WATER WELL RECORD
KSA 82a-1201-1215

Kansas Department of Health and
Environment-Division of Environment
(Water well Contractors)
Topeka, Kansas 66620

DCA

1. Location of well:		County <u>RAWLINS</u>	Fraction <u>NE 1/4 SW 1/4 SE 1/4</u>	Section number <u>26</u>	Township number <u>T 5 S R 34 E W</u>	Range number <u>34</u>
Distance and direction from nearest town or city: <u>16 N. 2 3/8 W. COLBY, KS.</u>				3. Owner of well: <u>Marlin Hinrichs</u> R.R. or street: <u>410 Smith Drive</u> City, state, zip code: <u>Colby, Kansas 67701</u>		
Locate with "X" in section below:		Sketch map:		6. Bore hole dia. <u>22</u> in. Completion date <u>5-1-77</u> Well depth <u>142</u> ft.		
				7. Cable tool ☐ Rotary ☐ Driven ☐ Dug ☐ Hollow rod ☐ Jetted ☐ Bored ☒ Reverse rotary		
5. Type and color of material				8. Use: ☐ Domestic ☐ Public supply ☐ Industry ☒ Irrigation ☐ Air conditioning ☐ Stock ☐ Lawn ☐ Oil field water ☐ Other		
Topsail, clay, silty, brown				9. Casing: Material <u>Steel</u> Height: Above or below Threaded ☐ Welded ☒ Surface <u>12</u> in. RMP ☐ PVC ☒ Weight <u>30</u> lbs./ft.		
Fine sand, Med Gravel, brown				Dia. <u>12 3/4</u> in. to <u>14 1/2</u> ft. depth Wall Thickness: inches or Dia. <u>12 3/4</u> in. to <u>14 1/2</u> ft. depth gauge No. <u>219</u>		
Fine sand, brown, Sandstone, White				10. Screen: Manufacturer's name <u>Lake wood pipe</u> Type <u>Slot</u> Dia. <u>12 3/4</u> Slot/gauze <u>1/8</u> Length <u>60</u> Set between <u>82</u> ft. and <u>142</u> ft. Gravel pack? ☒ Size range of material <u>1/4-1/2</u>		
Fine sand, brown, Sandstone traces white				11. Static water level: <u>30</u> ft. below land surface Date <u>6-22-77</u>		
Fine sand, brown, Traces sandstone white				12. Pumping level below land surfaces: <u>130</u> ft. after <u>9</u> hrs. pumping <u>350</u> g.p.m. <u> </u> ft. after <u> </u> hrs. pumping <u> </u> g.p.m. Estimated maximum yield <u>350</u>		
Fine sand, brown, Sandstone, white				13. Water sample submitted: Yes ☒ No ☐ Date <u>INDICATES</u>		
Sandy clay, brown				14. Well head completion: Pitless adapter <u>12</u> inches above grade		
Fine sand, brown				15. Well grouted? <u>yes</u> With: ☐ Neat cement ☒ Bentonite ☐ Concrete Depth: From <u>0</u> ft. to <u>10</u> ft.		
Fine sand, Med Gravel, brown				16. Nearest source of possible contamination: ft. <u>25</u> Direction <u>South</u> Type <u>Septic Tank</u> Well disinfected upon completion? Yes ☒ No ☐		
Ochre, yellow, Shale, blue				17. Pump: Manufacturer's name <u>ATC</u> Installed Model number <u>10R44</u> HP <u>60</u> Volts <u>240</u> Length of drop pipe <u>130</u> ft. capacity <u>350</u> g.p.m. Type: ☒ Submersible ☐ Turbine ☐ Reciprocating ☐ Other		
BROCK 137				20. Water well contractor's certification: This well was drilled under my supervision and this report is true to the best of my knowledge and belief. <u>RED TIGER IRRIGATION</u> Business name <u>Red Tiger Irrigation</u> License No. <u>625A</u> Address <u>Box 524 - Colby, KS.</u> Signed <u>Dave Glaser</u> Date <u>8-22-77</u> Authorized representative		
18. Elevation:		19. Remarks:				
Topography: ☐ Hill ☒ Slope ☐ Upland ☐ Valley		(Use a second sheet if needed)				

