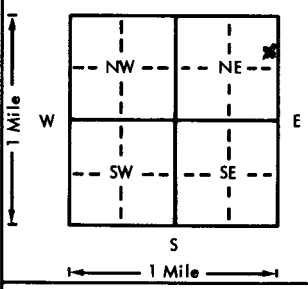


USE TYPEWRITER OR BALL
POINT PEN-PRESS FIRMLY,
PRINT CLEARLY.

WATER WELL RECORD
KSA 82a-1201-1215

Kansas Department of Health and
Environment-Division of Environment
(Water well Contractors)
Topeka, Kansas 66620

ADD

1. Location of well:		County Rawlins	Fraction SE 1/4 SE 1/4 NE 1/4	Section number 31	Township number T 5 S R 34 E/W	Range number
2. Distance and direction from nearest town or city: 13 N - 2 E 1/2 N Street address of well location if in city: from Levant				3. Owner of well: Charles Cook R.R. or street: City, state, zip code: Colby Kansas 67701		
4. Locate with "X" in section below: 				Sketch map: 6. Bore hole dia. 8.8 in. Completion date 12-20-77 Well depth 149 ft.		
5. Type and color of material				7. <input type="checkbox"/> Cable tool <input type="checkbox"/> Rotary <input type="checkbox"/> Driven <input type="checkbox"/> Dug <input type="checkbox"/> Hollow rod <input type="checkbox"/> Jetted <input type="checkbox"/> Bored <input checked="" type="checkbox"/> Reverse rotary		
				8. Use: <input type="checkbox"/> Domestic <input type="checkbox"/> Public supply <input type="checkbox"/> Industry <input checked="" type="checkbox"/> Irrigation <input type="checkbox"/> Air conditioning <input type="checkbox"/> Stock <input type="checkbox"/> Lawn <input type="checkbox"/> Oil field water <input type="checkbox"/> Other		
				9. Casing: Material Steel Height Above or below Threaded <input type="checkbox"/> Welded <input checked="" type="checkbox"/> Surface 2.2 in. RMP <input type="checkbox"/> PVC <input type="checkbox"/> Weight <input type="checkbox"/> lbs./ft. Dia. 16 in. to 149 ft. depth Wall Thickness: inches or Dia. <input type="checkbox"/> in. to <input type="checkbox"/> ft. depth gage No. 188		
				10. Screen: Manufacturer's name WA BROWN Type LUVER Dia. 16 Slot/gauze 7/8 Length 40 Set between 109 ft. and 149 ft. Gravel pack? <input type="checkbox"/> Size range of material 1/4 K 5/8		
				11. Static water level: <input type="checkbox"/> mo./day/yr. 123 ft. below land surface Date 12-19-77		
				12. Pumping level below land surfaces: ____ ft. after ____ hrs. pumping ____ g.p.m. ____ ft. after ____ hrs. pumping ____ g.p.m. Estimated maximum yield 750 g.p.m.		
				13. Water sample submitted: ____ mo./day/yr. Yes <input checked="" type="checkbox"/> No <input type="checkbox"/> Date		
				14. Well head completion: ____ Pitless adapter 12 Inches above grade		
				15. Well grouted? <input checked="" type="checkbox"/> With: <input checked="" type="checkbox"/> Neat cement <input type="checkbox"/> Bentonite <input type="checkbox"/> Concrete Depth: From 0 ft. to 10 ft.		
				16. Nearest source of possible contamination: ft. ____ Direction ____ Type HAZ Well disinfected upon completion? ____ Yes <input type="checkbox"/> No <input checked="" type="checkbox"/>		
				17. Pump: ____ Not installed Manufacturer's name ____ Model number 12 JHC HP 100 Volts ____ Length of drop pipe 240 ft. capacity 700 g.p.m. Type: <input type="checkbox"/> Submersible <input checked="" type="checkbox"/> Turbine <input type="checkbox"/> Jet <input type="checkbox"/> Reciprocating <input type="checkbox"/> Centrifugal <input type="checkbox"/> Other		
				20. Water well contractor's certification: This well was drilled under my jurisdiction and this report is true to the best of my knowledge and belief. Blue Jay Drilling Co 214 Business name License No. Address Box 503 Colby Ka Signed Monty Rall Date 4-29 Authorized representative		
				18. Elevation:		
				19. Remarks: (Use a second sheet if needed)		
				Topography: <input type="checkbox"/> Hill <input checked="" type="checkbox"/> Slope <input checked="" type="checkbox"/> Upland <input type="checkbox"/> Valley		