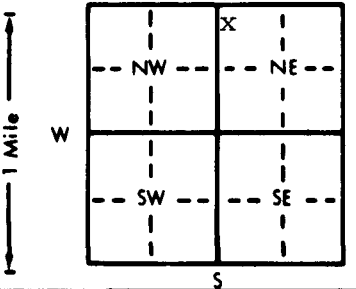


1 LOCATION OF WATER WELL:		Fraction		Section Number		Township Number		Range Number	
County: <u>Rawlins</u>		NW ¼ NW ¼ NE ¼		6		T 5 S		R 36 W E/W	
Distance and direction from nearest town or city street address of well if located within city? N/A - LOCATION CONFIRMED BY GMD #4									
2 WATER WELL OWNER: <u>Guy L. Cooper</u> RR#, St. Address, Box # : <u>Farm Mgt. Dept. 1st Bank of Lincoln</u> City, State, ZIP Code : <u>Lincoln, NE 68501</u> Board of Agriculture, Division of Water Resources Application Number:									
3 LOCATE WELL'S LOCATION WITH AN "X" IN SECTION BOX:			4 DEPTH OF COMPLETED WELL <u>290</u> ft. ELEVATION:						
			Depth(s) Groundwater Encountered 1. ft. 2. ft. 3. ft.						
			WELL'S STATIC WATER LEVEL <u>140</u> ft. below land surface measured on mo/day/yr						
			Pump test data: Well water was ft. after hours pumping gpm						
			Est. Yield gpm: Well water was ft. after hours pumping gpm						
			Bore Hole Diameter in. to ft., and in. to ft.						
WELL WATER TO BE USED AS:			5 Public water supply 8 Air conditioning 11 Injection well						
1 Domestic 3 Feedlot 6 Oil field water supply 9 Dewatering			12 Other (Specify below)						
2 Irrigation 4 Industrial 7 Lawn and garden only 10 Monitoring well			<u>TEST HOLE</u>						
Was a chemical/bacteriological sample submitted to Department? Yes.....No.....; If yes, mo/day/yr sample was submitted									
Water Well Disinfected? Yes No									
5 TYPE OF BLANK CASING USED:									
1 Steel 3 RMP (SR) 5 Wrought iron 8 Concrete tile CASING JOINTS: Glued Clamped									
2 PVC 4 ABS 6 Asbestos-Cement 9 Other (specify below) Welded									
7 Fiberglass <u>NONE</u> Threaded									
Blank casing diameter in. to ft., Dia. in. to ft., Dia. in. to ft.									
Casing height above land surface <u>5</u> in., weight lbs./ft. Wall thickness or gauge No.									
TYPE OF SCREEN OR PERFORATION MATERIAL:									
1 Steel 3 Stainless steel 5 Fiberglass 7 PVC 10 Asbestos-cement									
2 Brass 4 Galvanized steel 6 Concrete tile 8 RMP (SR) 11 Other (specify)									
9 ABS 12 None used (open hole)									
SCREEN OR PERFORATION OPENINGS ARE:									
1 Continuous slot 3 Mill slot 5 Gauzed wrapped 8 Saw cut 11 None (open hole)									
2 Louvered shutter 4 Key punched 6 Wire wrapped 9 Drilled holes									
7 Torch cut 10 Other (specify)									
SCREEN-PERFORATED INTERVALS: From ft. to ft., From ft. to ft.									
From ft. to ft., From ft. to ft.									
GRAVEL PACK INTERVALS: From ft. to ft., From ft. to ft.									
From ft. to ft., From ft. to ft.									
6 GROUT MATERIAL: 1 Neat cement 2 Cement grout 3 Bentonite 4 Other									
Grout Intervals: From <u>3</u> ft. to <u>6</u> ft., From ft. to ft., From ft. to ft.									
What is the nearest source of possible contamination:									
1 Septic tank 4 Lateral lines 7 Pit privy 10 Livestock pens 14 Abandoned water well									
2 Sewer lines 5 Cess pool 8 Sewage lagoon 11 Fuel storage 15 Oil well/Gas well									
3 Watertight sewer lines 6 Seepage pit 9 Feedyard 12 Fertilizer storage 16 Other (specify below)									
13 Insecticide storage <u>NONE</u>									
Direction from well? <u>NORTH</u> How many feet? <u>15</u>									
FROM TO LITHOLOGIC LOG FROM TO PLUGGING INTERVALS									
ENTER									
PLUGGING <u>Volunteer</u> 15 6 <u>NO CASING</u>									
6 3 <u>Clay</u>									
3 0 <u>Cement</u>									
0 <u>Clay</u>									
INFORMATION <u>RECEIVED</u>									
AT FEB 07 1990									
DIVISION OF ENVIRONMENT									
THIS WAS AN OPEN TEST HOLE									
The depth and static water level was original									
7 CONTRACTOR'S OR LANDOWNER'S CERTIFICATION: This water well was (1) constructed, (2) reconstructed, or (3) plugged under my jurisdiction and was completed on (mo/day/year) <u>1-2-90</u> and this record is true to the best of my knowledge and belief. Kansas Water Well Contractor's License No. This Water Well Record was completed on (mo/day/yr) under the business name of by (signature) <u>Dean Knapp</u>									