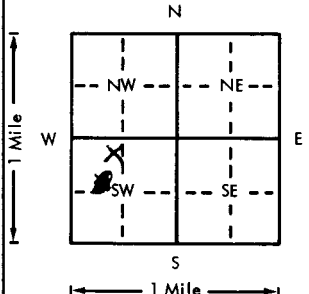
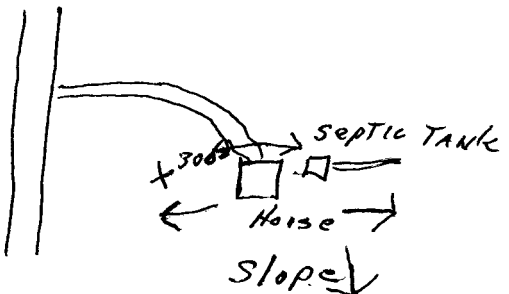


USE TYPEWRITER OR BALL  
POINT PEN-PRESS FIRMLY,  
PRINT CLEARLY.

WATER WELL RECORD  
KSA 82a-1201-1215

Kansas Department of Health and  
Environment-Division of Environment  
(Water well Contractors)  
Topeka, Kansas 66620

1. Location of well: <u>RAWLINS</u>		County: <u>RAWLINS</u>	Fraction: <u>NE 1/4 NW 1/4 SW 1/4</u>	Section number: <u>16</u>	Township number: <u>T 5 S R 36 W</u>	Range number: <u>36</u>
2. Distance and direction from nearest town or city: <u>12 miles South</u> Street address of well location if in city: <u>of McDonald</u>				3. Owner of well: <u>JOE KRAMER</u> R.R. or street: <u>Route 2</u> City, state, zip code: <u>Brewster, KAN</u>		
4. Locate with "X" in section below: 		Sketch map: 		6. Bore hole dia. <u>8</u> in. Completion date <u>4/23</u> Well depth <u>173</u> ft. Drilled		
5. Type and color of material				7. Cable tool <input checked="" type="checkbox"/> Rotary <input type="checkbox"/> Driven <input type="checkbox"/> Dug <input type="checkbox"/> Hollow rod <input type="checkbox"/> Jetted <input type="checkbox"/> Bored <input type="checkbox"/> Reverse rotary		
Top soil				8. Use: <input checked="" type="checkbox"/> Domestic <input type="checkbox"/> Public supply <input type="checkbox"/> Industry <input type="checkbox"/> Irrigation <input type="checkbox"/> Air conditioning <input type="checkbox"/> Stock <input type="checkbox"/> Lawn <input type="checkbox"/> Oil field water <input type="checkbox"/> Other		
Clay				9. Casing: Material <u>PVC</u> Height: Above or below Threaded <input type="checkbox"/> Welded <input type="checkbox"/> Surface <u>24</u> in. RMP <input type="checkbox"/> PVC <input checked="" type="checkbox"/> Weight <input type="checkbox"/> lbs./ft. Dia. <u>5</u> in. to <u>173</u> ft. depth Wall Thickness: inches or Dia. <input type="checkbox"/> in. to <input type="checkbox"/> ft. depth gage No. <u>822</u>		
Clay				10. Screen: Manufacturer's name <u>Jesse Howell</u> Type <u>PVC</u> Dia. <u>5"</u> Slot/gauge <input type="checkbox"/> Length <u>10'</u> Set between <u>163</u> ft. and <u>173</u> ft. ft. and <input type="checkbox"/> ft. Gravel pack? <u>yes</u> Size range of material <u>3 to 5</u>		
Rock				11. Static water level: <input type="checkbox"/> mg./day/yr. <u>120</u> ft. below land surface Date <u>4/23/23</u>		
Sand				12. Pumping level below land surfaces: <input type="checkbox"/> ft. after <input type="checkbox"/> hrs. pumping <input type="checkbox"/> g.p.m. <input type="checkbox"/> ft. after <input type="checkbox"/> hrs. pumping <input type="checkbox"/> g.p.m. Estimated maximum yield <input type="checkbox"/> g.p.m.		
Sand				13. Water sample submitted: <input type="checkbox"/> mo./day/yr. Yes <input type="checkbox"/> No <input type="checkbox"/> Date <input type="checkbox"/>		
Sand				14. Well head completion: <input type="checkbox"/> Pitless adapter <input type="checkbox"/> inches above grade		
Shale				15. Well grouted? <input checked="" type="checkbox"/> With: <input checked="" type="checkbox"/> Neat cement <input type="checkbox"/> Bentonite <input type="checkbox"/> Concrete Depth: From <input type="checkbox"/> ft. to <input type="checkbox"/> ft.		
Shale				16. Nearest source of possible contamination: ft. <u>300</u> Direction <u>East</u> Type <u>Septic Tank</u> Well disinfected upon completion? <input checked="" type="checkbox"/> Yes <input type="checkbox"/> No		
Shale				17. Pump: Manufacturer's name <input type="checkbox"/> Not installed Model number <input type="checkbox"/> HP <input type="checkbox"/> Volts <input type="checkbox"/> Length of drop pipe <input type="checkbox"/> ft. capacity <input type="checkbox"/> g.p.m. Type: <input type="checkbox"/> Submersible <input type="checkbox"/> Turbine <input type="checkbox"/> Jet <input type="checkbox"/> Reciprocating <input type="checkbox"/> Centrifugal <input type="checkbox"/> Other		
(Use a second sheet if needed)						
18. Elevation:		19. Remarks:		20. Water well contractor's certification: This well was drilled under my jurisdiction and this report is true to the best of my knowledge and belief. <u>HA Drilling</u> <u>331</u> Business name License No. Address <u>Atwood, Kan.</u> Signed <u>Harry A. Drilling</u> Date <u>4/20/23</u> Authorized Representative		