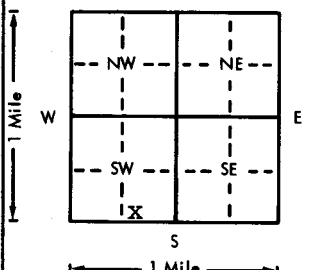


USE TYPEWRITER OR BALL
POINT PEN-PRESS FIRMLY,
PRINT CLEARLY.

WATER WELL RECORD
KSA 82a-1201-1215

Kansas Department of Health and
Environment-Division of Environment
(Water well Contractors)
Topeka, Kansas 66620

1. Location of well:	County Rawlins	Fraction SW 1/4 SE 1/4 SW 1/4	Section number #20	Township number T 5 S R 36 E/W	Range number
2. Distance and direction from nearest town or city: 18 miles North & 1 mile West, 3/4 mile South of Brewster, Ks.			3. Owner of well: Mr. Buell Briney R.R. or street: City, state, zip code: Brewster, Ks. 67732		
4. Locate with "X" in section below: Sketch map: 			6. Bore hole dia. 28 in. Completion date 8-5-75 Well depth 143 ft.		
5. Type and color of material			7. <input type="checkbox"/> Cable tool <input type="checkbox"/> Rotary <input type="checkbox"/> Driven <input type="checkbox"/> Dug <input type="checkbox"/> Hollow rod <input type="checkbox"/> Jetted <input type="checkbox"/> Bored <input checked="" type="checkbox"/> Reverse rotary		
			8. Use: <input type="checkbox"/> Domestic <input type="checkbox"/> Public supply <input type="checkbox"/> Industry <input checked="" type="checkbox"/> Irrigation <input type="checkbox"/> Air conditioning <input type="checkbox"/> Stock <input type="checkbox"/> Lawn <input type="checkbox"/> Oil field water <input type="checkbox"/> Other		
			9. Casing: Material <u>steel</u> Height <u>Above</u> or below Threaded <input type="checkbox"/> Welded <input checked="" type="checkbox"/> Surface <u>12"</u> in. RMP <input type="checkbox"/> PVC <input type="checkbox"/> Weight <u>188</u> lbs. Dia. <u>16</u> in. to <u>53</u> ft. depth Wall Thickness: inches or Dia. <u> </u> in. to <u> </u> ft. depth Gauge No. <u>7</u>		
			10. Screen: Manufacturer's name <u>W. A. Brown</u> Type <u>bridge</u> Dia. <u>16"</u> Slot/gauze <u>1/8</u> Length <u>2"</u> Set between <u>53</u> ft. and <u>133</u> ft. <u>10' of cook</u> ft. and <u>143'</u> Gravel pack? <u>yes</u> Size range of material <u>1/4 x 5/8</u>		
			11. Static water level: <u>18</u> ft. below land surface Date <u>8-10-75</u> 12. Pumping level below land surfaces: <u>70</u> ft. after <u>2</u> hrs. pumping <u>1850</u> g.p.m. <u> </u> ft. after <u> </u> hrs. pumping <u> </u> g.p.m. Estimated maximum yield <u>1850</u> g.p.m.		
13. Water sample submitted: <u> </u> mo./day/yr. <u> </u> Yes <input checked="" type="checkbox"/> No <input type="checkbox"/> Date <u> </u>			14. Well head completion: <u>12</u> inches above grade <u> </u> Pitless adapter		
15. Well grouted? <u>yes</u> With: <u> </u> Neat cement <input checked="" type="checkbox"/> Bentonite <u> </u> Concrete Depth: From <u>0</u> ft. to <u>10</u> ft.			16. Nearest source of possible contamination: ft. <u>2,000</u> Direction <u>West</u> Type <u>Farmstead</u> Well disinfected upon completion? <u> </u> Yes <input type="checkbox"/> No <input type="checkbox"/>		
17. Pump: <input checked="" type="checkbox"/> Not installed Manufacturer's name <u> </u> Model number <u> </u> HP <u> </u> Volts <u> </u> Length of drop pipe <u> </u> ft. capacity <u> </u> g.p.m. Type: <u> </u> Submersible <u> </u> Turbine <u> </u> Jet <u> </u> Reciprocating <u> </u> Centrifugal <u> </u> Other			18. Elevation:		
19. Remarks: Concrete Slab installed when pump set, 3229			20. Water well contractor's certification: This well was drilled under my jurisdiction and this report is true to the best of my knowledge and belief. Western Well & Pump, Inc. 245 Business name <u> </u> License No. <u> </u> Address <u>P.O. Box 852, Colby, Ks.</u> Signed <u>Roy Senior</u> Date <u>9-8-75</u> Authorized representative		

5 360 20 SW SE SW
T R Sec 1/4 1/4 1/4