

1 LOCATION OF WATER WELL:	Fraction	Section Number	Township Number	Range Number
County: <u>Rawlins</u>	<u>se</u> $\frac{1}{4}$ <u>SW</u> $\frac{1}{4}$ <u>se</u> $\frac{1}{4}$	<u>28</u>	<u>T</u> <u>5</u> <u>S</u>	<u>R</u> <u>36</u> <u>EW</u>

Distance and direction from nearest town or city street address of well if located within city?

14½ miles south of McDonald, Ks.2 WATER WELL OWNER: Harold McKee

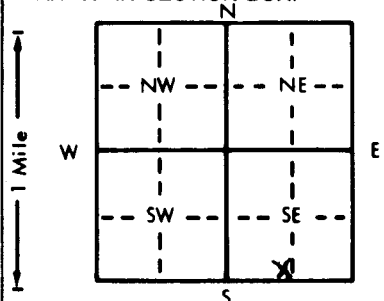
RR#, St. Address, Box # :

City, State, ZIP Code : Brewster, Kansas 67732

Board of Agriculture, Division of Water Resources

Application Number:

3 LOCATE WELL'S LOCATION WITH AN "X" IN SECTION BOX:

4 DEPTH OF COMPLETED WELL: 303' ft. ELEVATION:

Depth(s) Groundwater Encountered 1. ft. 2. ft. 3. ft.

WELL'S STATIC WATER LEVEL 155 ft. below land surface measured on mo/day/yr 8-3-89

Pump test data: Well water was ft. after hours pumping gpm

Est. Yield gpm: Well water was ft. after hours pumping gpm

Bore Hole Diameter 9 in. to ft., and in. to ft.

WELL WATER TO BE USED AS: 5 Public water supply 8 Air conditioning 11 Injection well

1 Domestic 3 Feedlot 6 Oil field water supply 9 Dewatering 12 Other (Specify below)

2 Irrigation 4 Industrial 7 Lawn and garden only 10 Monitoring well

Was a chemical/bacteriological sample submitted to Department? Yes.....No.....X.....; If yes, mo/day/yr sample was submittedWater Well Disinfected? Yes X No

5 TYPE OF BLANK CASING USED:

1 Steel 3 RMP (SR)

2 PVC 4 ABS

5 Wrought iron

6 Asbestos-Cement

7 Fiberglass

8 Concrete tile

9 Other (specify below)

CASING JOINTS: Glued X Clamped

Welded

Threaded

Blank casing diameter 5 in. to 283 ft., Dia 18 in. to 2.81 in. to 265 ft.Casing height above land surface 18 in., weight 2.81 lbs./ft. Wall thickness or gauge No. 265

TYPE OF SCREEN OR PERFORATION MATERIAL:

1 Steel 3 Stainless steel

2 Brass 4 Galvanized steel

5 Fiberglass

6 Concrete tile

7 PVC

8 RMP (SR)

9 ABS

10 Asbestos-cement

11 Other (specify)

12 None used (open hole)

SCREEN OR PERFORATION OPENINGS ARE:

1 Continuous slot 3 Mill slot

2 Louvered shutter 4 Key punched

5 Gauzed wrapped

6 Wire wrapped

7 Torch cut

8 Saw cut

9 Drilled holes

10 Other (specify)

11 None (open hole)

SCREEN-PERFORATED INTERVALS: From 283 ft. to 303 ft., From ft. to ft.

From ft. to ft., From ft. to ft.

GRAVEL PACK INTERVALS: From 20 ft. to 303 ft., From ft. to ft.

From ft. to ft., From ft. to ft.

6 GROUT MATERIAL:

1 Neat cement

2 Cement grout

3 Bentonite

4 Other

Grout intervals: From 0 ft. to 20 ft., From ft. to ft., From ft. to ft.

What is the nearest source of possible contamination:

1 Septic tank

4 Lateral lines

7 Pit privy

10 Livestock pens

14 Abandoned water well

2 Sewer lines

5 Cess pool

8 Sewage lagoon

11 Fuel storage

15 Oil well/Gas well

3 Watertight sewer lines 6 Seepage pit

9 Feedyard

12 Fertilizer storage

16 Other (specify below)

13 Insecticide storage

160

Direction from well? East

How many feet?

FROM	TO	LITHOLOGIC LOG	FROM	TO	PLUGGING INTERVALS
0	3	Surface	216	221	Clay
3	87	Clay	221	226	Caliche Cemented Strks.
87	91	Med. Sand	226	231	Clay & Caliche
91	107	Caliche	231	244	Sand
107	109	Med. Sand	244	247	Fine Sand
109	140	Clay	247	250	Clay & Caliche
140	142	Cemented Sand	250	263	Fine Sand (Tight)
142	148	Med. Sand	263	273	Med. Sand
148	155	Clay	273	282	Cemented Sand
155	171	Med. Sand Cemented Strks	282	302	Med. Sand
171	192	Med. Sand	302	303	Ochre
192	197	Sandy Clay			
197	199	Caliche (Hard)			
199	202	Clay			
202	216	Caliche Cemented Strks.			

7 CONTRACTOR'S OR LANDOWNER'S CERTIFICATION: This water well was (1) constructed, (2) reconstructed, or (3) plugged under my jurisdiction and was completed on (mo/day/year) 8-3-89 and this record is true to the best of my knowledge and belief. KansasWater Well Contractor's License No. 394 This Water Well Record was completed on (mo/day/yr) 8-7-89under the business name of Woofter Pump & Well Service by (signature) Walter Woofter