


1 LOCATION OF WATER WELL: Fraction Section Number Township Number Range Number
 COUNTY: CHEYENNE SW 1/4 NE 1/4 NE 1/4 28 T 5 S R 38 W

Distance and direction from nearest town or city street address of well if located within city?
 FROM GOODLAND; APPX 17 MILES NORTH & 7 MILES EAST

2 WATER WELL OWNER: HINES FARMS Board of Agriculture, Division of Water Resources
 RR#, St. Address, Box #: PO BOX 488 Application Number: 8,608
 City, State, ZIP code: COLBY, KS 67701-2932

3 LOCATE WELL'S LOCATION WITH AN "X" IN SECTION BOX: 4 DEPTH OF COMPLETED WELL 295 ELEVATION: 0
 Depth(s) Groundwater Encountered 1. 0 ft. 2. 0 ft. 3. 0 ft.

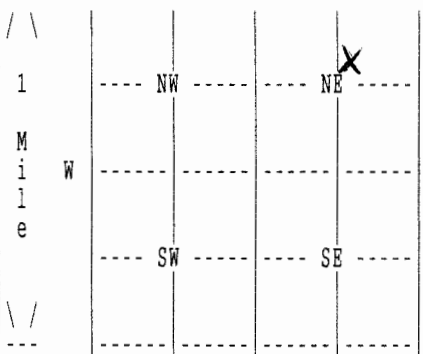

WELL'S STATIC WATER LEVEL 115 ft. below land surface measured on mo/day/yr 2/10/05
 Pump test data: Well water was 0 ft. after 0 hours pumping 0 gpm
 Estimated Yield 0 gpm: Well water was 0 ft. after 0 hours pumping 0 gpm
 Bore Hole Diameter 24 in. to 295 ft., and in. to 0 ft.
 WELL WATER TO BE USED AS: 02 IRRIGATION
 Was a chemical/bacteriological sample submitted to department? No ;
 If yes, mo/day/yr sample was submitted Water well disinfected? Yes

5 TYPE OF BLANK CASING USED: 01 STEEL CASING JOINTS: WELDED
 Blank casing diameter 16 in. to 295 ft., Dia in. to 0 ft., Dia in. to 0 ft.
 Casing height above land surface 12 in., weight 42 lbs/ft. Wall thickness or gauge No. .250
 TYPE OF SCREEN OR PERFORATION MATERIAL: 01 STEEL
 SCREEN OR PERFORATION OPENINGS ARE: 01 CONT. SLOT

SCREEN PERFORATED INTERVALS: From 144 ft. to 164 ft., From 0 ft. to 0 ft.
 From 180 ft. to 290 ft., From 0 ft. to 0 ft.
 GRAVEL PACK INTERVALS: From 20 ft. to 295 ft., From 0 ft. to 0 ft.
 From 0 ft. to 0 ft., From 0 ft. to 0 ft.

6 GROUT MATERIAL 03 BENTONITE
 Grout Intervals: From 0 ft. to 20 ft., From 0 ft. to 0 ft., From 0 ft. to 0 ft.
 What is the nearest source of possible contamination: NONE OBSERVED
 Direction from well? How many feet? 0

FROM	TO	LITHOLOGIC LOG	FROM	TO	PLUGGING INTERVALS
0	2	02 SILT			
2	28	04 SANDY CLAY 20 LIMESTONE			
28	47	05 SAND 13 FINE GRAVEL 14 MED GRAVEL			
47	64	04 SANDY CLAY 20 LIMESTONE			
64	90	05 SAND 13 FINE GRAVEL			
90	96	01 CLAY			
96	157	05 SAND 13 FINE GRAVEL 01 CLAY			
157	180	01 CLAY 20 LIMESTONE			
180	221	07 FINE SAND 08 MEDIUM SAND 01 CLAY			
221	275	07 FINE SAND 08 MEDIUM SAND			

7 CONTRACTOR'S OR LANDOWNER'S CERTIFICATION: This water well was Constructed under my jurisdiction and was completed on (mo/day/year) 02/10/05 and this record is true to the best of my knowledge and belief. Kansas Water Well Contractor's License No. 145 This Water Well Record was completed on (mo/day/yr) 06/15/05 under the business name of HENKLE DRILLING & SUPPLY by (signature)

1 LOCATION OF WATER WELL: COUNTY: CHEYENNE	Fraction SW 1/4 NE 1/4 NE 1/4	Section Number 28	Township Number T 5 S	Range Number R 38 W
--	---	-----------------------------	---------------------------------	-------------------------------

2 WATER WELL OWNER: RR#, St. Address, Box # : City, State, ZIP code :	HINES FARMS PO BOX 488 COLBY, KS 67701-2932	Board of Agriculture, Division of Water Resources Application Number: 8,608
---	--	--

FROM	TO	LITHOLOGIC LOG
275	290	05 SAND
290	300	19 SHALE

7 CONTRACTOR'S OR LANDOWNER'S CERTIFICATION: This water well was Constructed under my jurisdiction and was completed on (mo/day/year) 02/10/05 and this record is true to the best of my knowledge and belief. Kansas

Water Well Contractor's License No. 145

This Water Well Record was completed on (mo/day/yr) 06/15/05

under the business name of **HENKLE DRILLING & SUPPLY**

by (signature)

Brian J. Richman