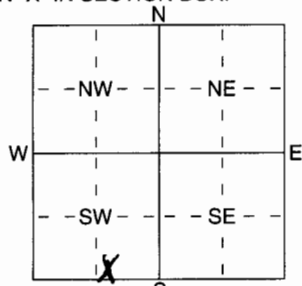


1 LOCATION OF WATER WELL: Fraction SW 1/4 SE 1/4 SW 1/4 Section Number 36 Township Number T 5 S Range Number R 38 E/W
 County: CHEYENNE

Distance and direction from nearest town or city street address of well if located within city?
13 MILES SOUTH OF BIRD CITY

2 WATER WELL OWNER: DANIEL BUSSE
 RR#, St. Address, Box #: H C 1 Board of Agriculture, Division of Water Resources
 City, State, ZIP Code: BIRD CITY, KS 67731 Application Number:

3 LOCATE WELL'S LOCATION WITH AN "X" IN SECTION BOX:

 4 DEPTH OF COMPLETED WELL 300 ft. ELEVATION:
 Depth(s) Groundwater Encountered 1 159 ft. 2 ft. 3 6-6-07 ft.
 WELL'S STATIC WATER LEVEL 159 ft. below land surface measured on mo/day/yr
 Pump test data: Well water was ft. after hours pumping gpm
 Est. Yield 20 gpm: Well water was ft. after hours pumping gpm
 WELL WATER TO BE USED AS:
 1 Domestic 3 Feedlot 6 Oil field water supply 9 Dewatering 12 Other (Specify below)
 2 Irrigation 4 Industrial 7 Domestic (lawn & garden) 10 Monitoring well
 Was a chemical/bacteriological sample submitted to Department? Yes No X; If yes, mo/day/yr sample was submitted
 Water Well Disinfected? Yes No

5 TYPE OF BLANK CASING USED:
 1 Steel PVC 3 RMP (SR) 5 Wrought iron 8 Concrete tile CASING JOINTS: Grouted Clamped
 4 ABS 6 Asbestos-Cement 9 Other (specify below) Welded
 7 Fiberglass Threaded
 Blank casing diameter 5 in. to 260 ft., Dia in. to ft., Dia in. to ft.
 Casing height above land surface 12" in., weight 2.384 lbs./ft. Wall thickness or gauge No. SDR 21
 TYPE OF SCREEN OR PERFORATION MATERIAL:
 1 Steel 3 Stainless Steel 5 Fiberglass 7 PVC 10 Asbestos-Cement
 2 Brass 4 Galvanized Steel 6 Concrete tile 8 RMP (SR) 11 Other (Specify)
 9 ABS 12 None used (open hole)
 SCREEN OR PERFORATION OPENINGS ARE:
 1 Continuous slot 3 Mill slot 5 Gauzed wrapped 8 Saw cut 11 None (open hole)
 2 Louvered shutter 4 Key punched 6 Wire wrapped 9 Drilled holes
 7 Torch cut 10 Other (specify) ft.
 SCREEN-PERFORATED INTERVALS: From 260 ft. to 300 ft., From ft. to ft.
 GRAVEL PACK INTERVALS: From ft. to ft., From ft. to ft.
PEA GRAVEL From 20 ft. to 300 ft., From ft. to ft.

6 GROUT MATERIAL: 1 Neat cement 2 Cement grout 3 Bentonite 4 Other
 Grout Intervals: From 0 ft. to 20 ft., From ft. to ft., From ft. to ft.
 What is the nearest source of possible contamination:
 1 Septic tank 4 Lateral lines 7 Pit privy 10 Livestock pens 14 Abandoned water well
 2 Sewer lines 5 Cess pool 8 Sewage lagoon 11 Fuel storage 15 Oil well/Gas well
 3 Watertight sewer lines 6 Seepage pit 9 Feedyard 12 Fertilizer storage 16 Other (specify below)
 13 Insecticide storage
 Direction from well? NONE IN VIEW How many feet?

| FROM | TO | LITHOLOGIC LOG | FROM | TO | PLUGGING INTERVALS |
|------|-----|----------------|------|----|--------------------|
| 0 | 40 | CLAY | | | |
| 40 | 60 | SANDSTONE-CLAY | | | |
| 60 | 80 | GRAVEL-CLAY | | | |
| 80 | 100 | CLAY | | | |
| 100 | 140 | GRAVEL-CLAY | | | |
| 140 | 160 | SANDSTONE-CLAY | | | |
| 160 | 180 | GRAVEL-CLAY | | | |
| 180 | 200 | GRAVEL | | | |
| 200 | 220 | GRAVEL-CLAY | | | |
| 220 | 240 | STONE-CLAY | | | |
| 240 | 260 | CLAY | | | |
| 260 | 280 | GRAVEL-CLAY | | | |
| 280 | 300 | SHALE | | | |

7 CONTRACTOR'S OR LANDOWNER'S CERTIFICATION: This water well was (1) constructed (2) reconstructed, or (3) plugged under my jurisdiction and was completed on (mo/day/year) 6-6-07 and this record is true to the best of my knowledge and belief. Kansas Water Well Contractor's Licence No 484 This Water Well Record was completed on (mo/day/yr) 6-15-07 under the business name of SCHAAL DRILLING CO by (signature) [Signature]