

WATER WELL RECORD

Form WWC-5

Division of Water Resources App. No.


8901 & 20825

1 LOCATION OF WATER WELL: County: CHEYENNE	Fraction ¼ NE ¼ SE ¼ NW ¼	Section Number 16	Township No. T 5 S	Range Number R 39 <input type="checkbox"/> E <input checked="" type="checkbox"/> W
--	------------------------------	----------------------	-----------------------	---

Street/Rural Address of Well Location; if unknown, distance & direction from nearest town or intersection: If at owner's address, check here .
9 MILES SOUTH - 1/2 EAST 1/4 SOUTH OF WHEELER, KS

Global Positioning System (GPS) information:
 Latitude: (in decimal degrees)
 Longitude: (in decimal degrees)
 Elevation:
 Datum: WGS 84, NAD 83, NAD 27
 Collection Method:
 GPS unit (Make/Model:)
 Digital Map/Photo, Topographic Map, Land Survey
 Est. Accuracy: <3 m, 3-5 m, 5-15 m, >15 m

2 WATER WELL OWNER: CLARENCE ROBERSON
 RR#, Street Address, Box #: 1955 ROAD E
 City, State, ZIP Code : ST FRANCIS KS 67756-5734

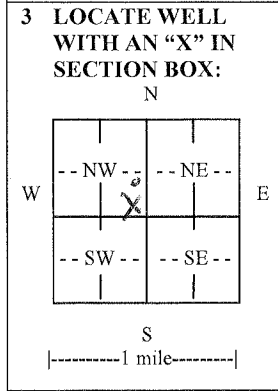

4 DEPTH OF COMPLETED WELL: 353 ft.

Depth(s) Groundwater Encountered (1) 213 ft. (2) ft. (3) ft.

WELL'S STATIC WATER LEVEL ft. below land surface measured on mo/day/yr.

Pump test data: Well water was 425 ft. after hours pumping gpm

EST. YIELD 425 gpm. Well water was ft. after hours pumping gpm

Bore Hole Diameter 26 in. to 353 ft., and in. to ft.

WELL WATER TO BE USED AS: Public water supply Geothermal Injection well
 Domestic Feedlot Oil field water supply Dewatering Other (Specify below)
 Irrigation Industrial Domestic-lawn & garden Monitoring well

Was a chemical/bacteriological sample submitted to Department? Yes No

If yes, mo/day/yr sample was submitted.

Water well disinfected? Yes No

5 TYPE OF CASING USED: Steel PVC Other

CASING JOINTS: Glued Clamped Welded Threaded

Casing diameter .16 in. to .353 ft., Diameter in. to ft., Diameter in. to ft.

Casing height above land surface .12 in., Weight lbs./ft., Wall thickness or gauge No.250

TYPE OF SCREEN OR PERFORATION MATERIAL:
 Steel Stainless Steel PVC Other (Specify)
 Brass Galvanized Steel None used (open hole)

SCREEN OR PERFORATION OPENINGS ARE:
 Continuous slot Mill slot Gauze wrapped Torch cut Drilled holes None (open hole)
 Louvered shutter Key punched Wire wrapped Saw cut Other (specify)

SCREEN-PERFORATED INTERVALS: From223 ft. to353 ft., From ft. to ft.
 From ft. to ft., From ft. to ft.

GRAVEL PACK INTERVALS: From353 ft. to20 ft., From ft. to ft.
 From ft. to ft., From ft. to ft.

6 GROUT MATERIAL: Neat cement Cement grout Bentonite Other

Grout Intervals: From20 ft. to0 ft., From ft. to ft., From ft. to ft.

What is the nearest source of possible contamination:
 Septic tank Lateral lines Pit privy Livestock pens Insecticide storage Other (specify below)
 Sewer lines Cesspool Sewage lagoon Fuel storage Abandoned water well
 Watertight sewer lines Seepage pit Feedyard Fertilizer storage Oil well/gas well

Direction from well900 Distance from well ..NORTH.....

FROM	TO	LITHOLOGIC LOG	FROM	TO	LITHO. LOG (cont.) or PLUGGING INTERVALS
201	218	CLAY - SAND FINE	323	336	OCHRA - SHALE
218	232	CLAY SANDSTONE - GRAVEL	336	353	Shale
232	250	CLAY - SAND STRIPS			
250	255	LINESTONE HARD			
255	259	SANDSTONE - CLAY			
259	265	CLAY			
265	280	SAND - FINE GRAVEL - CLAY			
280	291	CLAY & SAND			
291	304	FINE SAND - CLAY			
304	323	CLAY - SAND STRIPS			

7 CONTRACTOR'S OR LANDOWNER'S CERTIFICATION: This water well was constructed, reconstructed, or plugged under my jurisdiction and was completed on (mo/day/year) 4-3-12 and this record is true to the best of my knowledge and belief. Kansas Water Well Contractor's License No. 722. This Water Well Record was completed on (mo/day/year) 04-26-2012 under the business name of WESTERN SPRINKLERS, INC by (signature) Paul D. Miller

INSTRUCTIONS: Use typewriter or ball point pen. PLEASE PRESS FIRMLY and PRINT clearly. Please fill in blanks and check the correct answers. Send three copies (white, blue, pink) to Kansas Department of Health and Environment, Bureau of Water, Geology Section, 1000 SW Jackson St., Suite 420, Topeka, Kansas 66612-1367. Telephone 785-296-5524. Send one copy to WATER WELL OWNER and retain one for your records. Include fee of \$5.00 for each constructed well. Visit us at <http://www.kdheks.gov/waterwell/index.html>.

Original Returned to Sender
for Correction Date: 5-2-12