


1 LOCATION OF WATER WELL: County: Cloud Fraction NW 1/4 NE 1/4 NW 1/4 Section Number 4 Township Number T 5 S Range Number R 4 E/W

Distance and direction from nearest town or city street address of well if located within city? 1/2 mi. E, 3 mi. S, 1/2 mi. W of Norway

2 WATER WELL OWNER: Spur Feeders RR#, St. Address, Box #: RR2, Box 27A City, State, ZIP Code: Concordia, Kansas 66901 Board of Agriculture, Division of Water Resources Application Number:

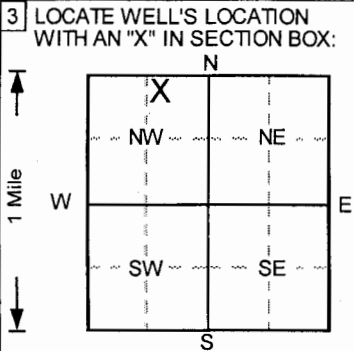

3 LOCATE WELL'S LOCATION WITH AN 'X' IN SECTION BOX: 4 DEPTH OF COMPLETED WELL: 24 ft. ELEVATION: 0. WELL'S STATIC WATER LEVEL: 13.55 ft. below land surface measured on 7/6/2006. Pump test data: Well water was NA ft. after ... hours pumping ... gpm. Est. Yield: NA gpm. Well water was ... ft. after ... hours pumping ... gpm. Bore Hole Diameter: 8 in. to 24 ft., and ... in. to ... ft. WELL WATER TO BE USED AS: 5 Public water supply, 8 Air conditioning, 11 Injection well, 1 Domestic, 3 Feedlot, 6 Oil field water supply, 9 Dewatering, 12 Other (Specify below), 2 Irrigation, 4 Industrial, 7 Lawn and garden only, 10 Monitoring well.

5 TYPE OF BLANK CASING USED: 1 Steel, 2 PVC (circled), 3 RMP (SR), 4 ABS, 5 Wrought iron, 6 Asbestos-Cement, 7 Fiberglass, 8 Concrete tile, 9 Other (specify below), CASING JOINTS: Glued, Clamped, Welded, Threaded (checked). Blanking diameter: 2 in. to 9 ft., Dia ... in. to ... ft., Dia ... in. to ... ft. Casing height above land surface: +24 in., weight ... lbs./ft. Wall thickness or gauge No. Sch. 40. TYPE OF SCREEN OR PERFORATION MATERIAL: 1 Steel, 2 Brass, 3 Stainless steel, 4 Galvanized steel, 5 Fiberglass, 6 Concrete tile, 7 PVC (circled), 8 RMP (SR), 10 Asbestos-cement, 11 Other (specify), 12 None used (open hole). SCREEN OR PERFORATION OPENINGS ARE: 1 Continuous slot, 2 Louvered shutter, 3 Mill slot (circled), 4 Key punched, 5 Gauzed wrapped, 6 Wire wrapped, 7 Torch cut, 8 Saw cut, 9 Drilled holes, 11 None (open hole), 10 Other (specify). SCREEN-PERFORATED INTERVALS: From 9 ft. to 24 ft., From ... ft. to ... ft., From ... ft. to ... ft. GRAVEL PACK INTERVALS: From 7 ft. to 24 ft., From ... ft. to ... ft., From ... ft. to ... ft.

6 GROUT MATERIAL: 1 Neat cement, 2 Cement grout, 3 Bentonite (circled), 4 Other Concrete (circled). Grout Intervals: From 0 ft. to 2 ft., From 2 ft. to 7 ft., From ... ft. to ... ft. What is the nearest source of possible contamination: 1 Septic tank, 2 Sewer lines, 3 Watertight sewer lines, 4 Lateral lines, 5 Cess pool, 6 Seepage pit, 7 Pit privy, 8 Sewage lagoon, 9 Feedyard, 10 Livestock pens, 11 Fuel storage, 12 Fertilizer storage, 13 Insecticide storage, 14 Abandoned water well, 15 Oil well/Gas well, 16 Other (specify below). Direction from well? How many feet? 0

Table with 6 columns: FROM, TO, LITHOLOGIC LOG, FROM, TO, PLUGGING INTERVALS. Rows include Sand topsoil (0-5), Sand, silty (5-10), Sand, coarse grained (10-24), MW1, Abovegrade, Project Name: Spur Feeders, GeoCore # 1131, #.

7 CONTRACTOR'S OR LANDOWNER'S CERTIFICATION: This water well was 1 constructed, 2 reconstructed, or 3 plugged under my jurisdiction and was completed on 6/30/2006 and this record is true to the best of my knowledge and belief. Kansas Water Well Contractor's License No. 527. This Water Well Record was completed on 7/18/2006 under the business name of GeoCore, Inc. by signature Dale Blf.