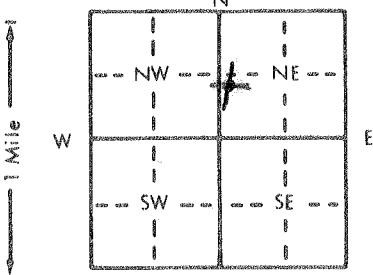


1] LOCATION OF WATER WELL: Fraction NW 1/4 SW 1/4 NE 1/4 Section Number 16 Township Number T 5 S Range Number R 4 W
 County: Cloud

Distance and direction from nearest town or city street address of well if located within city?
4 1/2 miles East & 1 mile North of Jamestown

2] WATER WELL OWNER: Dick & Dean Hanson
 RR#, St. Address, Box #: R.R. 1, Box 35 Board of Agriculture, Division of Water Resources
 City, State, ZIP Code: Jamestown, KS 66948 Application Number: #31,778

3] LOCATE WELL'S LOCATION WITH AN "X" IN SECTION BOX:

 4] DEPTH OF COMPLETED WELL: 82 ft. ELEVATION:
 Depth(s) Groundwater Encountered 1. 17 ft. 2. ft. 3. ft.
 WELL'S STATIC WATER LEVEL 17 ft. below land surface measured on mo/day/yr 5-19-94
 Pump test data: Well water was ft. after hours pumping gpm
 Est. Yield 2000 gpm: Well water was ft. after hours pumping gpm
 Bore Hole Diameter 40 in. to 82 ft., and in. to ft.
 WELL WATER TO BE USED AS:
 5 Public water supply 8 Air conditioning 11 Injection well
 1 Domestic 3 Feedlot 6 Oil field water supply 9 Dewatering 12 Other (Specify below)
2 Irrigation 4 Industrial 7 Lawn and garden only 10 Monitoring well
 Was a chemical/bacteriological sample submitted to Department? Yes.....No.....X.....; If yes, mo/day/yr sample was submitted
 Water Well Disinfected? Yes X No

5] TYPE OF BLANK CASING USED:
 1 Steel 3 RMP (SR) 5 Wrought iron 8 Concrete tile CASING JOINTS: Glued X Clamped
 2 PVC 4 ABS 6 Asbestos-Cement 9 Other (specify below) Welded
 7 Fiberglass Threaded
 Blank casing diameter 1.6 in. to 42 ft., Dia in. to ft., Dia in. to ft.
 Casing height above land surface 12 in., weight 16.15 lbs./ft. Wall thickness or gauge No. 500

TYPE OF SCREEN OR PERFORATION MATERIAL:
 1 Steel 3 Stainless steel 5 Fiberglass 7 PVC 10 Asbestos-cement
 2 Brass 4 Galvanized steel 6 Concrete tile 8 RMP (SR) 11 Other (specify)
 12 None used (open hole)
 SCREEN OR PERFORATION OPENINGS ARE:
 1 Continuous slot 3 Mill slot 5 Gauzed wrapped 8 Saw cut 11 None (open hole)
 2 Louvered shutter 4 Key punched 6 Wire wrapped 9 Drilled holes
 7 Torch cut 10 Other (specify)
 SCREEN-PERFORATED INTERVALS: From 42 ft. to 82 ft., From ft. to ft.
 From ft. to ft., From ft. to ft.
 GRAVEL PACK INTERVALS: From 20 ft. to 82 ft., From ft. to ft.
 From ft. to ft., From ft. to ft.

6] GROUT MATERIAL: 1 Neat cement 2 Cement grout 3 Bentonite 4 Other
 Grout Intervals: From 0 ft. to 20 ft., From ft. to ft., From ft. to ft.
 What is the nearest source of possible contamination: None within 1/2 mile 10 Livestock pens 14 Abandoned water well
 1 Septic tank 4 Lateral lines 7 Pit privy 11 Fuel storage 15 Oil well/Gas well
 2 Sewer lines 5 Cess pool 8 Sewage lagoon 12 Fertilizer storage 16 Other (specify below)
 3 Watertight sewer lines 6 Seepage pit 9 Feedyard 13 Insecticide storage
 Direction from well? How many feet?

FROM	TO	LITHOLOGIC LOG	FROM	TO	PLUGGING INTERVALS
0	5	Top Soil			
5	16	Brown Silty Clay			
16	23	Brown Clay			
23	38	Medium Sand			
38	48	Medium to Course Sand			
48	62	Course Sand & Gravel			
62	64	Gray Clay			
64	80	Medium to Course Sand			
80	82	Fine Sand			

7] CONTRACTOR'S OR LANDOWNER'S CERTIFICATION: This water well was (1) constructed, (2) reconstructed, or (3) plugged under my jurisdiction and was completed on (mo/day/year) 5-19-94 and this record is true to the best of my knowledge and belief. Kansas Water Well Contractor's License No. 138 This Water Well Record was completed on (mo/day/yr) 5-23-94 under the business name of Peterson Irrigation Inc. by (signature) Mike Peterson