

1 LOCATION OF WATER WELL:	Fraction	Section Number	Township Number	Range Number
County: <u>Cherokee</u>	<u>NE 1/4 NE 1/4 NW 1/4</u>	<u>24</u>	T <u>5</u> S <u>5</u>	R <u>42</u> E <u>W</u>

Distance and direction from nearest town or city street address of well if located within city?

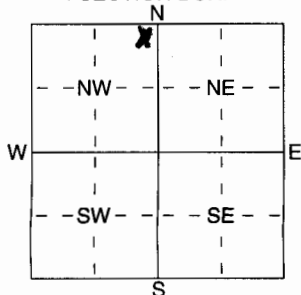
1/2 mile South + 10 miles West of St Francis2 WATER WELL OWNER: Melvin SchuppRR#, St. Address, Box # : Rt 1 Box 109City, State, ZIP Code : Manorville, KS 67741 225

Board of Agriculture, Division of Water Resources

Application Number:

3 LOCATE WELL'S LOCATION WITH 4 DEPTH OF COMPLETED WELL 225 ft. ELEVATION:

AN "X" IN SECTION BOX:

Depth(s) Groundwater Encountered 1 ft. 2 155 ft. 3 155 ft.WELL'S STATIC WATER LEVEL 155 ft. below land surface measured on mo/day/yr 7-26-06Pump test data: Well water was 10 gpm: Well water was 10 gpm: hours pumping 7-26-06 gpmEst. Yield 10 gpm: Well water was 10 gpm: hours pumping 7-26-06 gpm

WELL WATER TO BE USED AS: 5 Public water supply 8 Air conditioning 11 Injection well

1 Domestic 3 Feedlot 6 Oil field water supply 9 Dewatering 12 Other (Specify below)

2 Irrigation 4 Industrial 7 Domestic (lawn &amp; garden) 10 Monitoring well

Was a chemical/bacteriological sample submitted to Department? Yes X No   ; If yes, mo/day/yr sample was submitted Water Well Disinfected? Yes No

5 TYPE OF BLANK CASING USED:

1 Steel

3 RMP (SR)

5 Wrought iron

8 Concrete tile

CASING JOINTS: Glued Clamped2 PVC

4 ABS

6 Asbestos-Cement

9 Other (specify below)

Welded

7 Fiberglass

ThreadedBlank casing diameter 5 in. to 205 ft. Dia 12 in. to 200 lbs./ft. Wall thickness or gauge No. SDR 21Casing height above land surface 12 in., weight 200 lbs./ft.

TYPE OF SCREEN OR PERFORATION MATERIAL:

1 Steel

3 Stainless Steel

5 Fiberglass

7 PVC

10 Asbestos-Cement

2 Brass

4 Galvanized Steel

6 Concrete tile

8 RMP (SR)

11 Other (Specify)

9 ABS

12 None used (open hole)

SCREEN OR PERFORATION OPENINGS ARE:

1 Continuous slot

3 Mill slot

5 Gauzed wrapped

8 Saw cut

11 None (open hole)

2 Louvered shutter

4 Key punched

6 Wire wrapped

9 Drilled holes

7 Torch cut

10 Other (specify)    ft.SCREEN-PERFORATED INTERVALS: From 205 ft. to 225 ft., From    ft. to    ft.

GRAVEL PACK INTERVALS:

From 205 ft. to 225 ft., From    ft. to    ft.From 205 ft. to 225 ft., From    ft. to    ft.6 GROUT MATERIAL: Neat cementNeat cement

2 Cement grout

3 Bentonite

4 Other   Grout intervals: From 0 ft. to 20 ft., From 20 ft. to    ft., From    ft. to    ft.

What is the nearest source of possible contamination:

1 Septic tank

4 Lateral lines

7 Pit privy

10 Livestock pens

14 Abandoned water well

2 Sewer lines

5 Cess pool

8 Sewage lagoon

11 Fuel storage

15 Oil well/Gas well

3 Watertight sewer lines

6 Seepage pit

9 Feedyard

12 Fertilizer storage

16 Other (specify below)

13 Insecticide storage

Direction from well? None in Village

How many feet?

FROM	TO	LITHOLOGIC LOG	FROM	TO	PLUGGING INTERVALS
0	20	Clay			
20	40	Clay + Sand			
40	60	gravel sand + sandstone			
60	80	gravel + sand			
80	100	sand + sandstone			
100	120	sand + sandstone			
120	140	sand + sandstone			
140	200	sand			
200	220	sand + clay			
220	225	Shale			

7 CONTRACTOR'S OR LANDOWNER'S CERTIFICATION: This water well was (1) constructed (2) reconstructed, or (3) plugged under my jurisdiction and was completed on (mo/day/year) 7-26-06 and this record is true to the best of my knowledge and belief. KansasWater Well Contractor's License No. 484 This Water Well Record was completed on (mo/day/yr) 7-26-06 by (signature) Melvin Schupp

INSTRUCTIONS: Use typewriter or ball point pen. PLEASE PRESS FIRMLY and PRINT clearly. Please fill in blanks, underline or circle the correct answers. Send top three copies to Kansas Department of Health and Environment, Bureau of Water, Geology Section, 1000 SW Jackson St., Suite 420, Topeka, Kansas 66612-1367. Telephone 785-296-5522. Send one to WATER WELL OWNER and retain one for your records. Fee of \$5.00 for each constructed well.