


1 LOCATION OF WATER WELL: Fraction NE 1/4 NW 1/4 SW 1/4 Section Number 34 Township Number T 5 S Range Number R 42 EW
 County: CHEYENNE

Distance and direction from nearest town or city street address of well if located within city?

2 WATER WELL OWNER: KEITH BRACELIN
 RR#, St. Address, Box # : HWY 27 Board of Agriculture, Division of Water Resources
 City, State, ZIP Code : GOODLAND KS 67735 Application Number:

3 LOCATE WELL'S LOCATION WITH AN "X" IN SECTION BOX: 4 DEPTH OF COMPLETED WELL 210 ft. ELEVATION:

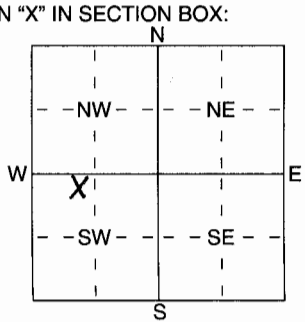

Depth(s) Groundwater Encountered 1 155 ft. 2 ft. 3 ft.
 WELL'S STATIC WATER LEVEL 155 ft. below land surface measured on mo/day/yr 7-26-06
 Pump test data: Well water was ft. after hours pumping gpm
 Est. Yield 5 gpm: Well water was ft. after hours pumping gpm
 WELL WATER TO BE USED AS: 5 Public water supply 8 Air conditioning 11 Injection well
 1 Domestic 3 Feedlot 6 Oil field water supply 9 Dewatering 12 Other (Specify below)
 2 Irrigation 4 Industrial 7 Domestic (lawn & garden) 10 Monitoring well

Was a chemical/bacteriological sample submitted to Department? Yes No X; If yes, mo/day/yr sample was submitted
 Water Well Disinfected? Yes No

5 TYPE OF BLANK CASING USED: 5 Wrought iron 8 Concrete tile CASING JOINTS: Glued Clamped
 1 Steel 3 RMP (SR) 6 Asbestos-Cement 9 Other (specify below) Welded
 2 PVC 4 ABS 7 Fiberglass Threaded

Blank casing diameter 5" in. to 150 ft., Dia in. to ft., Dia in. to ft.
 Casing height above land surface in., weight lbs./ft. Wall thickness or gauge No. SDR-26

TYPE OF SCREEN OR PERFORATION MATERIAL: 10 Asbestos-Cement
 1 Steel 3 Stainless Steel 5 Fiberglass 8 PVC 8 RMP (SR) 11 Other (Specify)
 2 Brass 4 Galvanized Steel 6 Concrete tile 9 ABS 12 None used (open hole)

SCREEN OR PERFORATION OPENINGS ARE: 5 Gauzed wrapped 8 Saw cut 11 None (open hole)
 1 Continuous slot 3 Mill slot 6 Wire wrapped 9 Drilled holes
 2 Louvered shutter 4 Key punched 7 Torch cut 10 Other (specify)

SCREEN-PERFORATED INTERVALS: From 150 ft. to 210 ft., From ft. to ft.
 GRAVEL PACK INTERVALS: From ft. to ft., From ft. to ft.
PEA GRAVEL From 20 ft. to 210 ft., From ft. to ft.

6 GROUT MATERIAL: 1 Neat cement 2 Cement grout 3 Bentonite 4 Other
 Grout Intervals: From 0 ft. to 20 ft., From ft. to ft., From ft. to ft.

What is the nearest source of possible contamination:
 1 Septic tank 4 Lateral lines 7 Pit privy 10 Livestock pens 14 Abandoned water well
 2 Sewer lines 5 Cess pool 8 Sewage lagoon 11 Fuel storage 15 Oil well/Gas well
 3 Watertight sewer lines 6 Seepage pit 9 Feedyard 12 Fertilizer storage 16 Other (specify below)
 13 Insecticide storage

Direction from well? NONE IN VIEW How many feet?

FROM	TO	LITHOLOGIC LOG	FROM	TO	PLUGGING INTERVALS
0	20	CLAY			
20	40	STONE- GRAVEL- CLAY			
40	60	SAND- CLAY			
60	80	SAND			
80	100	GRAVEL- SAND			
100	120	STONE- GRAVEL			
120	140	GRAVEL			
140	180	GRAVEL - CLAY			
180	200	GRAVEL- SAND- CLAY			
200	220	SHALE- SAND- CLAY			

7 CONTRACTOR'S OR LANDOWNER'S CERTIFICATION: This water well was (1) constructed (2) reconstructed, or (3) plugged under my jurisdiction and was completed on (mo/day/year) 7-26-06 and this record is true to the best of my knowledge and belief. Kansas Water Well Contractor's Licence No 484 This Water Well Record was completed on (mo/day/yr) 8-28-06 under the business name of SCHAAL DRILLING CO by (signature) Keith Bracelin