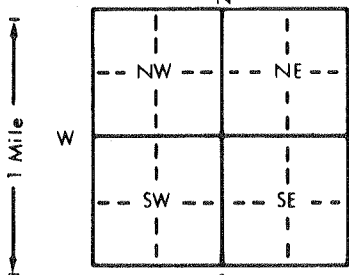


1 LOCATION OF WATER WELL:	Fraction	Section Number	Township Number	Range Number
County: CLOUD	1/4 1/4 NW 1/4	21	T 5 S	R 5 E/W

Distance and direction from nearest town or city street address of well if located within city?

2 WATER WELL OWNER: Dennis Larsen	Board of Agriculture, Division of Water Resources
RR#, St. Address, Box #: Jamestown, KS 66948	Application Number:
City, State, ZIP Code:	

3 LOCATE WELL'S LOCATION WITH AN "X" IN SECTION BOX:	4 DEPTH OF COMPLETED WELL: 138 ft. ELEVATION:
	Depth(s) Groundwater Encountered 1. 55 ft. 2. ft. 3. ft.
	WELL'S STATIC WATER LEVEL 55 ft. below land surface measured on mo/day/yr 3-15-95
	Pump test data: Well water was 80 ft. after 2 hours pumping 10 gpm
	Est. Yield 10 gpm: Well water was ft. after hours pumping gpm
	Bore Hole Diameter 10 in. to 138 ft., and in. to ft.
	WELL WATER TO BE USED AS:
	1 Domestic 3 Feedlot 6 Oil field water supply 9 Dewatering 12 Other (Specify below)
	2 Irrigation 4 Industrial 7 Lawn and garden only 10 Monitoring well
	Was a chemical/bacteriological sample submitted to Department? Yes. No. X; If yes, mo/day/yr sample was submitted
	Water Well Disinfected? Yes No

5 TYPE OF BLANK CASING USED:	5 Wrought iron	8 Concrete tile	CASING JOINTS: Glued X Clamped
1 Steel	3 RMP (SR)	6 Asbestos-Cement	9 Other (specify below)
2 PVC	4 ABS	7 Fiberglass	10 Asbestos-cement
Blank casing diameter 5 in. to 78 ft., Dia.			11 Other (specify)
Casing height above land surface 36 in., weight 5" class 200 P.V.C. lbs./ft.			12 None used (open hole)
TYPE OF SCREEN OR PERFORATION MATERIAL:			
1 Steel	3 Stainless steel	5 Fiberglass	8 RMP (SR)
2 Brass	4 Galvanized steel	6 Concrete tile	9 ABS
SCREEN OR PERFORATION OPENINGS ARE:			
1 Continuous slot	3 Mill slot	4 Gauzed wrapped	8 Saw cut
2 Louvered shutter	4 Key punched	6 Wire wrapped	9 Drilled holes
SCREEN-PERFORATED INTERVALS:			
From 28 ft. to 138 ft.			
GRAVEL PACK INTERVALS:			
From 20 ft. to 138 ft.			

6 GROUT MATERIAL:	1 Neat cement	2 Cement grout	3 Bentonite	4 Other
Grout Intervals: From 5 ft. to 25 ft.				
What is the nearest source of possible contamination:				
1 Septic tank	4 Lateral lines	7 Pit privy	10 Livestock pens	14 Abandoned water well
2 Sewer lines	5 Cess pool	8 Sewage lagoon	11 Fuel storage	15 Oil well/Gas well
3 Watertight sewer lines	6 Seepage pit	9 Feedyard	12 Fertilizer storage	16 Other (specify below)
Direction from well? SOUTH EAST				

FROM	TO	LITHOLOGIC LOG	FROM	TO	PLUGGING INTERVALS
0	5	Top soil			
5	15	Brown clay			
15	30	Yellow clay			
30	45	Yellow clay, Tan clay			
45	60	Yellow, Blue clay			
60	65	Yellow, Tan clay			
65	120	Blue Shale			
120	140	Tan shale, limestone layers			

7 CONTRACTOR'S OR LANDOWNER'S CERTIFICATION: This water well was (1) constructed, (2) reconstructed, or (3) plugged under my jurisdiction and was completed on (mo/day/year) 3/15/95 and this record is true to the best of my knowledge and belief. Kansas Water Well Contractor's License No. 480 This Water Well Record was completed on (mo/day/yr) 3/20/95 under the business name of WILLIAMS DRILLING CO. INC. by (signature) Williams
---