


1 LOCATION OF WATER WELL: Fraction NW 1/4 NW 1/4 NE 1/4 Section Number 25 Township Number T 5 S Range Number R 5 E **W**

County: Cloud

Distance and direction from nearest town or city street address of well if located within city?  
 Approximately 1 1/2 miles east of Jamestown

2 WATER WELL OWNER: Cloud County RWD #1  
 RR#, St. Address, Box # : P.O. Box 416 Board of Agriculture, Division of Water Resources  
 City, State, ZIP Code : Concordia, KS 66901 Application Number:

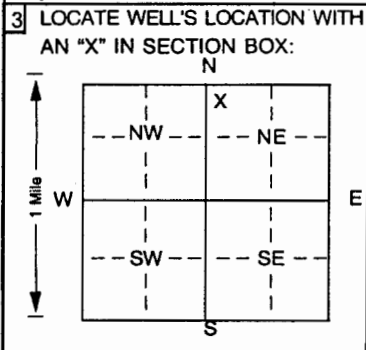

4 DEPTH OF COMPLETED WELL 70 ft. ELEVATION: unknown

Depth(s) Groundwater Encountered 1 ft. 2 ft. 3 ft. . ft.

WELL'S STATIC WATER LEVEL 14.92 ft. below land surface measured on mo/day/yr 11-23-04

Pump test data: Well water was not checked ft. after hours pumping gpm

Est. Yield unknown gpm: Well water was ft. after hours pumping gpm

Bore Hole Diameter 8 in. to 75 ft., and in. to ft.

WELL WATER TO BE USED AS: 5 Public water supply 8 Air conditioning 11 Injection well  
 1 Domestic 3 Feedlot 6 Oil field water supply 9 Dewatering 12 Other (specify below)  
 2 Irrigation 4 Industrial 7 Domestic (lawn & garden) **10** Monitoring well

Was a chemical/bacteriological sample submitted to Department? Yes No  If yes, mo/day/yr sample was submitted  
 Water Well Disinfected? Yes No

5 TYPE OF BLANK CASING USED: 5 Wrought iron 8 Concrete tile CASING JOINTS: Glued  Clamped  
 1 Steel 3 RMP (SR) 6 Asbestos-Cement 9 Other (specify below) Welded  
**2** PVC 4 ABS 7 Fiberglass Threaded

Blank casing diameter 5 in. to 53 ft., Dia in. to ft., Dia in. to ft.

Casing height above land surface 24 in., weight 2.36 lbs./ft. Wall thickness or gauge No .214

TYPE OF SCREEN OR PERFORATION MATERIAL: **7** PVC 10 Asbestos-cement  
 1 Steel 3 Stainless steel 5 Fiberglass 8 RMP (SR) 11 Other (specify)  
 2 Brass 4 Galvanized steel 6 Concrete tile 9 ABS 12 None used (open hole)

SCREEN OR PERFORATION OPENINGS ARE: 5 Gauzed wrapped 8 Saw cut 11 None (open hole)  
 1 Continuous slot **3** Mill slot 6 Wire wrapped 9 Drilled holes  
 2 Louvered shutter 4 Key punched 7 Torch cut 10 Other (specify) ft.

SCREEN-PERFORATED INTERVALS: From 53 ft. to 68 ft., From ft. to ft.  
 From ft. to ft., From ft. to ft.  
 GRAVEL PACK INTERVALS: From 32 ft. to 75 ft., From ft. to ft.  
 From ft. to ft., From ft. to ft.

6 GROUT MATERIAL: 1 Neat cement 2 Cement grout 3 Bentonite 4 Other Bentonite Holeplug

Grout Intervals: From ft. to ft., From ft. to ft., From 0 ft. to 32 ft.

What is the nearest source of possible contamination:  
 1 Septic tank 4 Lateral lines 7 Pit privy 10 Livestock pens 14 Abandoned water well  
 2 Sewer lines 5 Cess pool 8 Sewage lagoon 11 Fuel storage 15 Oil well/Gas well  
 3 Watertight sewer lines 6 Seepage pit 9 Feedyard 12 Fertilizer storage 16 Other (specify below)  
 13 Insecticide storage None known

Direction from well? How many feet?

FROM	TO	LITHOLOGIC LOG	FROM	TO	PLUGGING INTERVALS
0	3	Topsoil			
3	7	Clay, gray, hard			
7	32	Clay, brown, hard			
32	34	Sand and gravel, coarse to fine			
34	37	Clay, brown, hard			
37	53	Clay, dark gray, hard			
53	65	Sand and gravel, coarse to fine			
65	75	Sandstone, tan, clay streaks			

7 CONTRACTOR'S OR LANDOWNER'S CERTIFICATION: This water well was **(1) constructed**, (2) reconstructed, or (3) plugged under my jurisdiction and was completed on (mo/day/year) 11-23-04 and this record is true to the best of my knowledge and belief. Kansas Water Well Contractor's License No 185 This Water Well Record was completed on (mo/day/yr) 11-24-04 under the business name of Clarke Well & Equipment, Inc. by (signature)

INSTRUCTIONS: Use typewriter or ball point pen. PLEASE PRESS FIRMLY and PRINT clearly. Please fill in blanks, underline or circle the correct answers. Send top three copies to Kansas Department of Health and Environment, Bureau of Water, Topeka, Kansas 66620-0001. Telephone 785-296-5524. Send one to WATER WELL OWNER and retain one for your records. Fee of \$5.00 for each constructed well.