USE TYPEWRITER OR BALL POINT PEN-PRESS FIRMLY, PRINT CLEARLY.

WATER WELL RECORD
KSA 82a-1201-1215

Kansas Department of Health and Environment-Division of Environment
(Water well Contractors)
Topeka, Kansas 66620

1. Location of well:	County: Cloud	Fraction: (1/4) 1/4 SE 1/4	Section number: 3	Township number: T 6 S	Range number: R 1 E/W

2. Distance and direction from nearest town or city: 3 miles South of Clyde Kansas
Street address of well location if in city:

3. Owner of well: Francis Odette
R.R. or street: Rte #1
City, state, zip code: Clyde, Kansas 66938

4. Locate with "X" in section below:

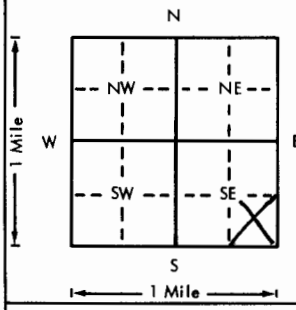

Sketch map:

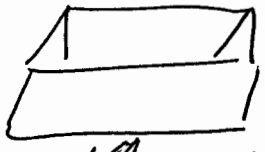

5. Type and color of material	From	To
Black soil	0	20
Grey Clay	20	50
Sand Stone	50	60
Red Clay	60	72
Sand Stone	72	135

(Use a second sheet if needed)

6. Bore hole dia. 8 in. Completion date Aug. 11, 1976
Well depth 135 ft.

7. ___ Cable tool ✓ Rotary ___ Driven ___ Dug
___ Hallow rod ___ Jetted ___ Bored ___ Reverse rotary

8. Use: ✓ Domestic ___ Public supply ___ Industry
___ Irrigation ___ Air conditioning ___ Stock
___ Lawn ___ Oil field water ___ Other

9. Casing: Material ___ Height: Above or below
Threaded ___ Welded ✓ Surface 12 in.
RMP ___ PVC ✓ Weight ___ lbs./ft.
Dia. 5 in. to 135 ft. depth Wall Thickness: inches or
Dia. ___ in. to ___ ft. depth gage No. 1/4

10. Screen: Manufacturer's name Vetstream
Type 160 Dia. 5"
Slat/gauze 64 Length 20 ft.
Set between 115 ft. and 135 ft.
___ ft. and ___ ft.
Gravel pack? ✓ Size range of material 1/4

11. Static water level: mo./day/yr.
60 ft. below land surface Date Aug. 13, 1976

12. Pumping level below land surfaces:
100 ft. after 4 hrs. pumping 10 g.p.m.
___ ft. after ___ hrs. pumping ___ g.p.m.
Estimated maximum yield 16 g.p.m.

13. Water sample submitted: mo./day/yr.
✓ Yes ___ No Date Aug. 15, 1976

14. Well head completion:
✓ Pitless adapter 12 Inches above grade

15. Well grouted?
With: ✓ Neat cement ___ Bentonite ✓ Concrete
Depth: From 1 ft. to 10 ft.

16. Nearest source of possible contamination:
ft. 250 Direction North Type Septic
Well disinfected upon completion? ✓ Yes ___ No

17. Pump: Red Jacket Not installed
Manufacturer's name
Model number 100 RJ HP 1 HP Volts 220
Length of drop pipe 110 ft. capacity 15 g.p.m.
Type:
✓ Submersible ___ Turbine
___ Jet ___ Reciprocating
___ Centrifugal ___ Other

18. Elevation: 1338
Topography:
___ Hill
✓ Slope
✓ Upland
___ Valley

19. Remarks:

20. Water well contractor's certification:
This well was drilled under my jurisdiction and this report is true to the best of my knowledge and belief. 247
Earl Thomas Sons
Business name License No.
Address 333E 16th Concordia KS
Signature Elmer Thomas Date Oct 13 1976
Authorized representative

T 6 — R 1 (E) (W) Sec 3 — 1/4 SE 1/4 1/4 1/4

Forward the white, blue and pink copies to the Department of Health and Environment

Form WWC-5

MI-1023