


1 LOCATION OF WATER WELL: Fraction SE 1/4 SE 1/4 NE 1/4 Section Number 4 Township Number T 6 S Range Number R 1 W EW  
 County: Cloud 015

Distance and direction from nearest town or city street address of well if located within city?  
1/2 mile South, 1/2 mile east of Ames

2 WATER WELL OWNER: Wilbur Appleby  
 RR#, St. Address, Box #: Route 1 Board of Agriculture, Division of Water Resources  
 City, State, ZIP Code: Clyde, KS 66938 Application Number: 10,585

3 LOCATE WELL'S LOCATION WITH AN "X" IN SECTION BOX:

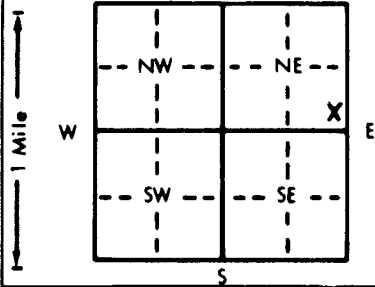

4 DEPTH OF COMPLETED WELL: 80' ft. ELEVATION: .....  
 Depth(s) Groundwater Encountered 1. 31' ft. 2. .... ft. 3. .... ft.  
 WELL'S STATIC WATER LEVEL 28 ft. below land surface measured on mo/day/yr 3-23-88  
 Pump test data: Well water was 80' ft. after 3/4 hours pumping 1,000 gpm  
 Est. Yield 1,000 gpm: Well water was ..... ft. after ..... hours pumping ..... gpm  
 Bore Hole Diameter: 30 in. to 80' ft., and ..... in. to ..... ft.  
 WELL WATER TO BE USED AS:  
 5 Public water supply 8 Air conditioning 11 Injection well  
 1 Domestic 3 Feedlot 6 Oil field water supply 9 Dewatering 12 Other (Specify below)  
X 2 Irrigation 4 Industrial 7 Lawn and garden only 10 Observation well  
 Was a chemical/bacteriological sample submitted to Department? Yes ..... No X .....; If yes, mo/day/yr sample was sub-  
 mitted Water Well Disinfected? Yes X No

5 TYPE OF BLANK CASING USED:  
 1 Steel 3 RMP (SR) X 6 Asbestos-Cement 8 Concrete tile CASING JOINTS: Glued ..... Clamped X .....  
 2 PVC 4 ABS 7 Fiberglass Welded .....  
 5 Wrought iron 8 Concrete tile Clamped X .....  
 Blank casing diameter 16 in. to 80 ft., Dia ..... in. to ..... ft., Dia ..... in. to ..... ft.  
 Casing height above land surface 12 in., weight XXX 34# lbs./ft. Wall thickness or gauge No. 3/4"  
 TYPE OF SCREEN OR PERFORATION MATERIAL:  
 1 Steel 3 Stainless steel 5 Fiberglass 8 RMP (SR) X 10 Asbestos-cement  
 2 Brass 4 Galvanized steel 6 Concrete tile 9 ABS 11 Other (specify) .....  
 SCREEN OR PERFORATION OPENINGS ARE:  
 5 Gauzed wrapped X 8 Saw cut 11 None (open hole)  
 1 Continuous slot 3 Mill slot 6 Wire wrapped 9 Drilled holes  
 2 Louvered shutter 4 Key punched 7 Torch cut 10 Other (specify) .....  
 SCREEN-PERFORATED INTERVALS: From 54 ft. to 80 ft., From ..... ft. to ..... ft.  
 GRAVEL PACK INTERVALS: From 20 ft. to 80 ft., From ..... ft. to ..... ft.

6 GROUT MATERIAL: 1 Neat cement X 2 Cement grout 3 Bentonite 4 Other .....  
 Grout Intervals: From 0 ft. to 20 ft., From ..... ft. to ..... ft., From ..... ft. to ..... ft.  
 What is the nearest source of possible contamination:  
 1 Septic tank 4 Lateral lines 7 Pit privy 10 Livestock pens X 14 Abandoned water well  
 2 Sewer lines 5 Cess pool 8 Sewage lagoon 11 Fuel storage 15 Oil well/Gas well  
 3 Watertight sewer lines 6 Seepage pit 9 Feedyard 12 Fertilizer storage 16 Other (specify below)  
 13 Insecticide storage  
 Direction from well? South How many feet? 60' (JED)

FROM	TO	LITHOLOGIC LOG	FROM	TO	LITHOLOGIC LOG
0	31	o/ Clay			
31	42	// Gravel			
42	56	o/ Clay			
56	80	// Gravel			

7 CONTRACTOR'S OR LANDOWNER'S CERTIFICATION: This water well was (1) constructed, (2) reconstructed, or (3) plugged under my jurisdiction and was completed on (mo/day/year) March 23, 1988 and this record is true to the best of my knowledge and belief. Kansas Water Well Contractor's License No. 361 This Water Well Record was completed on (mo/day/yr) March 24, 1988 under the business name of Cox-Beswick Irrigation Serv. Inc. by (signature) Annie Beswick

INSTRUCTIONS: Use typewriter or ball point pen. PLEASE PRESS FIRMLY and PRINT clearly. Please fill in blanks, underline or circle the correct answers. Send top three copies to Kansas Department of Health and Environment, Bureau of Water Protection, Topeka, Kansas 66620-7320, Telephone: 913-862-9360. Send one to WATER WELL OWNER and retain one for your records.