WATER WELL RECORD Form WWC-5 KSA 82a-1212 ID No. **MW-09**

1 LOCATION OF WATER WELL: County: **Osborne** | Fraction: **SW** ¼ **SE** ¼ **NE** ¼ | Section Number: **28** | Township Number: T **6** S | Range Number: R **11** E/W

Distance and direction from nearest town or city street address of well if located within city?
Railroad Ave. south road right-of-way at intersection of Railroad Ave. & 4Tth St.

2 WATER WELL OWNER: **KDHE DRYCLEANING PROGRAM**
RR#, St. Address, Box # : **Curtis Bldg, 1000 SW Jackson, Suite 410** Board of Agriculture, Division of Water Resources
City, State, ZIP Code : **Topeka, Ks 66612-1367** Application Number:

3 LOCATE WELL'S LOCATON WITH AN "X" IN SECTION BOX:

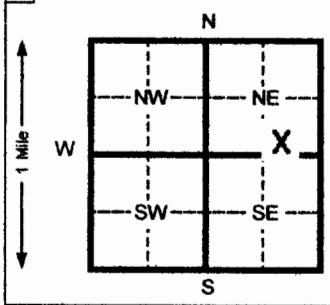

4 DEPTH OF COMPLETED WELL **66** ft. ELEVATION:
Depth(s) Groundwater Encountered 1 **27.75** ft. 2 ft. 3 ft.
WELL'S STATIC WATER LEVEL ft. below land surface measured on mo/day/yr
Pump test data: Well water was ft. after hours pumping gpm
Est. Yield gpm: Well water was ft. after hours pumping gpm
Bore Hole Diameter **8** in. to **66** ft. and in. to ft.
WELL WATER TO BE USED AS: 5 Public water supply 8 Air conditioning 11 Injection well
1 Domestic 3 Feed lot 6 Oil field water supply 9 Dewatering 12 Other (Specify below)
2 Irrigation 4 Industrial 7 Lawn and garden (domestic) [10] Monitoring well
Was a chemical/bacteriological sample submitted to Department? Yes No **X** If yes, mo/day/yr sample was submitted Water Well Disinfected? Yes No **X**

5 TYPE OF BLANK CASING USED: 5 Wrought Iron 8 Concrete tile CASING JOINTS: Glued Clamped
1 Steel 3 RMP (SR) 6 Asbestos-Cement 9 Other (specify below) Welded
2 PVC 4 ABS 7 Fiberglass Threaded **X**
Blank casing diameter **2** in. to **42.5** ft., Dia in. to ft., Dia in. to ft.
Casing height above land surface **0** in., weight **.716** lbs./ft. Wall thickness or gauge No. **.154**

TYPE OF SCREEN OR PERFORATION MATERIAL: [7] PVC 10 Asbestos-cement
1 Steel 3 Stainless steel 5 Fiberglass 8 RMP (SR) 11 Other (specify)
2 Brass 4 Galvanized steel 6 Concrete tile 9 ABS 12 None used (open hole)

SCREEN OR PERFORATION OPENINGS ARE: 5 Gauzed wrapped [8] Saw cut 11 None (open hole)
1 Continuous slot 3 Mill slot 6 Wire wrapped 9 Drilled holes
2 Louvered shutter 4 Key punched 7 Torch cut 10 Other (specify)

SCREEN-PERFORATED INTERVALS: From **42.5** ft. to **66** ft. From ft. to ft.
From ft. to ft. From ft. to ft.
GRAVEL PACK INTERVALS: From **24** ft. to **66** ft. From ft. to ft.
From ft. to ft. From ft. to ft.

6 GROUT MATERIAL: 1 Neat cement [2 Cement grout] [3 Bentonite] 4 Other
Grout Intervals From **0** ft. to **23** ft. From **23** ft. to **1.0** ft. From ft. to ft.

What is the nearest source of possible contamination:
1 Septic tank 4 Lateral lines 7 Pit privy 10 Livestock pens 14 Abandoned water well
2 Sewer lines 5 Cess pool 8 Sewage lagoon 11 Fuel storage 15 Oil well/ Gas well
3 Watertight sewer lines 6 Seepage pit 9 Feedyard 12 Fertilizer storage 16 Other (specify below)
13 Insecticide storage **Contaminated site**
Direction from well? How many feet?

FROM	TO	CODE	LITHOLOGIC LOG	FROM	TO	PLUGGING INTERVALS
0	.5		grass surface			
.5	5		CL-Silty lean clay			
5	10		ML-clayey silt			
10	15		cl-silty lean clay			
15	20		cl-silty lean clay			
20	25		CL-Silty lean clay			
25	30		ML-clayey silt			
30	35		SP-Poorly Graded Coarse Sd			
35	40		SP-Poorly graded coarse Sd			
40	45		Sp-Poorly graded coarse Sd			
45	60		Sp-Poorly graded coarse Sd			
60	65		ML-Sandy, clayey, silt			
65	66		Shale			

7 CONTRACTOR'S OR LANDOWNER'S CERTIFICATION: This water well was (1) constructed, (2) reconstructed, or (3) plugged under my jurisdiction and was completed on (mo/day/yr) **9-13-05** and this record is true to the best of my knowledge and belief. Kansas Water Well Contractor's License No. **554** This Water Well Record was completed on (mo/day/yr) **10-26-05**
under the business name of **Woofter Pump & Well Inc.** by (signature) Jerry C Woofter

INSTRUCTIONS:. Please fill in blanks and circle the correct answers. Send three copies to Kansas Department of Health and Environment, Bureau of Water, 1000 S W Jackson St., Ste. 420, Topeka, Kansas 66612-1367. Telephone: 913-296-5545. Send one to WATER WELL OWNER and retain one for your records.

OFFICE USE ONLY T R SEC